


SEC. 34, 50-6.

TWP. LINE

MEANDER CORNER.
BET. SEC. 34, 50-6
SEC. 2, 49-6

CLOSING COR.
3/2
49-6.

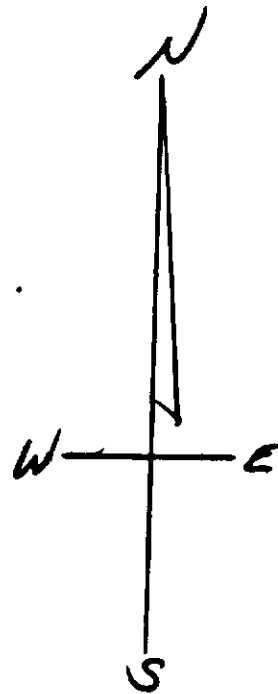

NO SCALE

SEC. LINE.

N. 0° 25' W, 2,688.69'

766.23'

296.12'

1,606.34'

I-1A

I-1B

GOVT LOTS
3, 4

LAKE SUPERIOR.

E-W. 1/4 LINE.

I-2A 596.15'

569.18'

I-2B

1/4 COR. BET.
SECS. 3/2, 49-6

BDB
7-15-81