

# SURVEY & REMONUMENTATION

MAY 05 1997

## LAND CORNER RECORDATION CERTIFICATE

Filing Requirement of Act 74, Mich. P.A. 1970

For corners in COMMISSION  
CRAWFORD  
(County)

Located In:

Corner Code #

1. Public Land Survey

T 25N R 2W

F-13

2. Property Controlling  
in Section

S      T      R       
S      T      R     

3. Miscellaneous  
Property in Section

S      T      R       
S      T      R     

4. Lot No.           , Recorded Plat           

5. Private Claims           

**LIBER 3 PAGE 249**

I, Marvin E. Myers, P.S., in a field survey on Nov, 1996, do hereby certify that under requirements of P.A. 74, Michigan P.A. of 1970, the corner points mentioned in lines 1 and 2 above were in conformance with regulations and rules therefore as required in the current manual of survey instructions of the United States Department of the Interior, Bureau of Land Management or by a decree of a Court of Law and/or that the corner points mentioned in lines 3, 4 and 5 above were in conformance with the rules of the Michigan Board of Professional Surveyors or by a Decree of a Court of Law; established, re-established, monumented, re-monumented, recovered, found as expressed below:

**NOTE: Not more than 4 corners, all in the same town and range, may be recorded on this certificate.**

### A. Description of original monument and accessories and/or subsequent restoration:

GLO W. Burt June 1852  
Mon-Post  
Wit- 9" P.Pine N45°W 1.06 Chs  
4" P.Pine N63°E 25 Lks.

LCRC L.3, P.34 M.E.Myers Nov. 1991  
Mon- Bolt in Pav't Box  
Wit- Face of U.Pole S55°E 82.00  
1/2" bar and cap #2240 South 33.00  
U.Pole S84°W 103.00  
Nail in W. Face 5" R. Pine N55°E 62.40  
Nail in W. Face 6" J. Pine N11°W 41.56

L.163, P.550 F.J.Arleth 1977  
Mon- Pav't Box  
L168, P.352 F.J. Arleth 1978  
Mon- Pav't Box


### B. Description of corner evidence found and/or method applied in restoring or reestablishing corner:

Found Bolt in pavement box. Found all accessories recorded in L.3, P. 34.

Accepted as the best available evidence of the position of the original corner.

### C. Description of monument for corner and accessories established to perpetuate locating the position of the corner:

Replaced with standard Roscommon County monument in pav't box.  
Wit: Utility Pole S84°W 103.00  
1/2" bar and Cap #2240 South 33.00  
Nail in West face 5" R. Pine N55°E 62.40  
Nail in W. fance 6" J. Pine N11°W 41.56

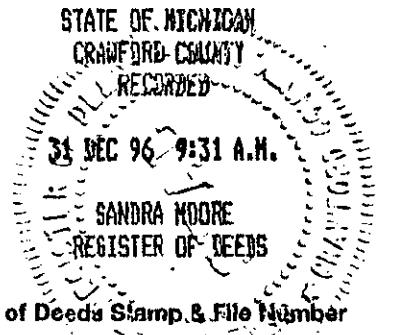

	A	B	C	D	E	F	G	H	I	J	K	L
2	6	5	4	3	2	1						
3												
4	7	6	5	4	3	2	1					
5												
6	10	9	8	7	6	5	4	3	2	1		
7												
8	19	18	17	16	15	14	13	12	11	10	9	8
9												
10	30	29	28	27	26	25	24	23	22	21	20	19
11												
12	31	30	29	28	27	26	25	24	23	22	21	20
13												

**CRAWFORD COUNTY**

**PEER GROUP APPROVAL**

DATE NOV 22 1996

*Marvin E. Myers* M.E.M.

Marvin E. Myers, P.S.  
County Surveyor

Signed by

*Marvin E. Myers*

Date

Dec 14, 1996

Surveyor's Michigan License No. 31600

FORM APPROVED BY MICHIGAN STATE BOARD OF PROFESSIONAL SURVEYORS, JAN. 28, 1971  
REVISED MAY 14, 1975  
REVISED JAN, 1993

