

APR 27 1995

COMMISSION

CRAWFORD COUNTY
PEER GROUP APPROVAL
DATE 12-29-94

LIBER 8 PAGE 164

LAND CORNER RECORDATION CERTIFICATE
Filing Requirement of Act 74, Mich. P.A. 1970

For corners in

Crawford
(County)

Located In:

Corner Code #

- | | | |
|------------------------------------|------------|--------|
| 1. Public Land Survey | T 25N R 2W | G - 10 |
| | T R | |
| | T R | |
| | T R | |
| 2. Property Controlling in Section | S T R | |
| | S T R | |
| 3. Miscellaneous Property in Sec. | S T R | |
| | S T R | |

STATE OF MICHIGAN
COUNTY OF CRAWFORD


FILED FOR RECORD THIS
30th DAY OF Dec, 1994 AT
4:20 am (pm) IN LIBER 3
PAGE 164.

Elizabeth W. Wiland
Register of Deeds & File Number

4. Lot No. _____, Recorded Plat _____
5. Private Claims _____

I, Marvin E. Myers, in a field survey on December 23, 19 94, do hereby certify that under requirements of P.A. 74, Michigan P.A. of 1970, the corner points mentioned in lines 1 and 2 above were in conformance with regulations and rules therefore as required in the current manual of survey instructions of the United States Department of the Interior, Bureau of Land Management or by a decree of a Court of Law and/or that the corner points mentioned in lines 3, 4 and 5 above were in conformance with the rules of the Michigan Board of Land Surveyors or by a Decree of a Court of Law; established, re-established, monumented, re-monumented, recovered, found as expressed below:

NOTE: Not more than 4 corners, all in the same town and range, may be recorded on this certificate.

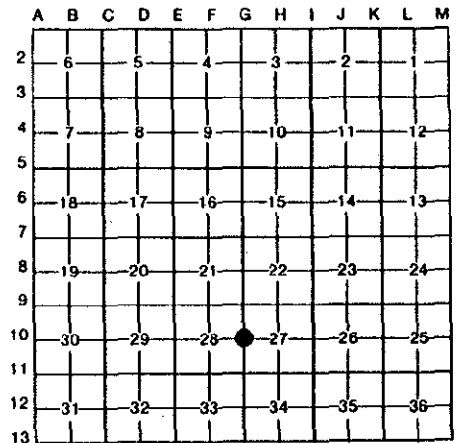

A. Description of original monument and accessories and/or subsequent restoration:


| | |
|--|--|
| GLO-D. Pettibone 1852 Mon-Set Post WIT: 4" Spr. Pine S38°E 23 lks. 6" Spr. Pine S51°W 80 lks. | N. Parker July 10, 1978 L.2, pg.177 LCRC Mon-Fd. 1/2" bar WIT: face of P. Pole West 41.5' NBT 6" J. Pine S28°W 98.8' |
| R. Ostling Oct. 9, 1956 Mon-1/2" bar WIT: None | L. Cavanagh July 12, 1994 L.384, pg.222 Mon-1/2" bar WIT: Spike in P. Pole West 31.43' Spike in 10" J. Pine SW 54.77' Spike in 20" B. Oak S05°W 72.75' Spike in 6" J. Pine N35°W 68.10' |

B. Description of corner evidence found and/or method applied in restoring or reestablishing corner:

Monument - Found 1/2" x 24" iron bar 3.8' East of centerline Chase Bridge Road
WIT: Fd. nail NW side 14" B. Oak S52°W 72.76'
Fd. nail SE side 15" J. Pine S79°W 54.77'
Fd. nail N. side U. Pole N85°W 31.41'
Fd. nail NE side 7" J. Pine N31°W 68.15'
Fd. 6" J. Pine stump S30°W 98.28'
Accepted as the best available evidence of the position of the Original Corner.

C. Description of monument for corner and accessories established to perpetuate locating the position of the corner:

Mon-Set Std. Crawford County Mon. stamped "T25N R2W G-10 31600" in Mon. Box in exact location of 1/2" bar
WIT: Fd. nail NW side 14" B. Oak S52°W 72.76'
Fd. nail SE side 15" J. Pine S79°W 54.77'
Fd. nail N. side U. Pole N85°W 31.41'
Fd. nail NE side 7" J. Pine N31°W 68.15'
Fd. 6" J. Pine stump S30°W 98.28'
Set carsonite post S85°E 32.37'

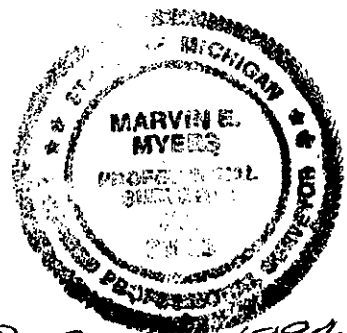

Signed by Marvin E. Myers
Surveyor's Michigan License No. 31600

Date Dec 27, 1994