

LAND CORNER RECORDATION CERTIFICATE  
Filing Requirement of Act 74, Mich. P.A. 1970

or corners in

<u>Crawford</u> <small>(County)</small>	Located In:	Corner Code: <u>M-7</u>
Public Land Survey	T <u>27N</u> R <u>1W</u>	<u>M-7</u>
	T _____ R _____	_____
	T _____ R _____	_____
	T _____ R _____	_____
Property Controlling in Section	S _____ T _____ R _____	_____
Miscellaneous	S _____ T _____ R _____	_____
Property in Sec.	S _____ T _____ R _____	_____

STATE OF MICHIGAN  
COUNTY OF CRAWFORD

FILED FOR RECORD THIS  
6th DAY OF June 1990 AT  
9:30 am pm, IN LIBER 2  
PAGE 379  
Ed. J. St. Wiland  
Register of Deeds

Register of Deeds Stamp & File Number

Lot No. \_\_\_\_\_, Recorded Plat \_\_\_\_\_  
Private Claims \_\_\_\_\_

Norman C. Caldwell a field survey on March, 1990  
hereby certify that under requirements of P.A. 74, Michigan P.A. of 1970, the corner points mentioned  
lines 1 and 2 above were in conformance with regulations and rules therefore as required in the  
current manual of survey instructions of the United States Department of the Interior, Bureau of Land  
Management or by a decree of a Court of Law and/or that the corner points mentioned in lines 3, 4 and 5  
above were in conformance with the rules of the Michigan Board of Land Surveyors or by a Decree of a  
Court of Law, established, re-established, monumented, re-monumented, recovered, found as  
expressed below:

**NOTE:** Not more than 4 corners, all in the same town and range, may be recorded  
on this certificate.

Description of original monument and accessories and/or subsequent restoration:


- (M-7) Post set by Hodgson & Sibley, May 18, 1839.  
Pine 14" N51 1/2°W .58 (38.28')
- W. Oak 9" S34°W .47 (31.02')

Description of corner evidence found and/or method applied in restoring or reestablishing corner:

- (M-7) LaGuire, 1934, fnd. iron & stone at corner position as verified  
by NW'ly orig. BT (corner perpetuated by Oscoda Co. surveyors)  
placed pipe & conc. block mon.  
K.J. Ostling, LS 10068, fnd. mon. and replaced with DNR pipe &  
cap June 28, 1979.  
N65°W 38.80 12" Oak  
S50°W 50.35 3" Maple

Description of monument for corner and accessories established to perpetuate locating the corner of the corner:

- (M-7) Stand. cor. 13&24, T27N-R1W  
Fnd. DNR pipe & cap near E. edge of road. This is a perpetuation  
of orig. cor. by Randall & Schaaf (LaGuire). And is accepted as  
a careful & faithful perpetuation of the position of the orig. cor.  
East 10' Carsonite Witness Post East 15.8' Red top post  
S50°E 40.0' 3" W. Pine  
N50°E 30.4' 14" Oak  
N65°W 39.2' 12" Oak (R)  
S50°W 51.6' 5" Maple (R)  
CL fire line West - North - South

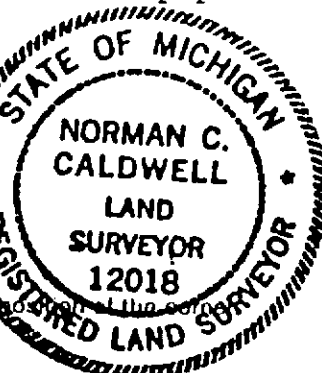

Witnessed by Norman C. Caldwell Date April 26, 1990  
Surveyor's Michigan License No. 12018

	A	B	C	D	E	F	G	H	I	J	K	L	M
2	6	5	4	3	2	1							
3													
4	7	8	9	10	11	12							
5													
6	16	17	18	19	20	21	22	23	24				
7													
8	19	20	21	22	23	24							
9													
10	30	29	28	27	26	25							
11													
12	31	32	33	34	35	36							
13													