

2-316

SURVEY &
REMONUMENTATION
APR 06 1995
COMMISSION

CHARLEVOIX COUNTY REMONUMENTATION
LAND CORNER RECORDATION CERTIFICATE
Filing Requirement of Act 74, Mich. P.A. 1970
ALSO ACT 345, PA 1990

STATE OF MICHIGAN
COUNTY OF CHARLEVOIX
RECEIVED FOR RECORD

1994 DEC 22 PM 1:58

Charlene M. Boskin
REGISTER OF DEEDS

For corners in
CHARLEVOIX
(County)

Located In: Corner Code #

1. Public Land Survey	T 32N R 4W	A-8
	T R	
	T R	
	T R	
	T R	
2. Property Controlling in Section	S T R	
	S T R	
3. Miscellaneous	S T R	
Property in Sec.	S T R	

Register of Deeds Stamp & File Number

4. Lot No. , Recorded Plat
5. Private Claims

I, Wayne E. Boss, in a field survey on September 27, 1994, do hereby certify that under requirements of P.A. 74, Michigan P.A. of 1970, the corner points mentioned in lines 1 and 2 above were in conformance with regulations and rules therefore as required in the current manual of survey instructions of the United States Department of the Interior, Bureau of Land Management or by a decree of a Court of Law and/or that the corner points mentioned in lines 3, 4 and 5 above were in conformance with the rules of the Michigan Board of Land Surveyors or by a Decree of a Court of Law; established, re-established, monumented, re-monumented, recovered, found as expressed below:

NOTE: Not more than 4 corners, all in the same town and range, may be recorded on this certificate.

	A	B	C	D	E	F	G	H	I	J	K	L	M
2	6	5	4	3	2	1							
3													
4	7	8	9	10	11	12							
5													
6	18	17	16	15	14	13							
7													
8	19	20	21	22	23	24							
9													
10	30	29	28	27	26	25							
11													
12	31	32	33	34	35	36							
13													

A. Description of original monument and accessories and/or subsequent restoration:

Set qr. Section post
1. Sugar 20" N33°E 31
2. Beech 8" S50°W 8
John Mullett May 1840

Re-wit ¼" Section post
1. Sugar 14" N51½°E 16½
2. Sugar 20" N89°W 19 lks.
E.A. Robinson 1902

Set Conc. Mon
on Line Equidist. bet.
A-7 and A-9
1. 10" yel. Birch S75°E 12.0'
2. 11' Elm N12½°W, 5.8'
Thomas Schweigert 1960

B. Description of corner evidence found and/or method applied in restoring or reestablishing corner:

Schweigert stated in his corner recital as recorded in Liber 1, Page 17 that corner was set equidistant between the NW cor. and the SW cor. of Sec.
GLO to A-7 2640 meas. 2647.49'
GLO to A-9 2640 meas. 2645.22'


C. Description of monument for corner and accessories established to perpetuate locating the position of the corner:

Fd. conc. mon 100'S of curve in rd. and 400'E of 2-track.
1. Fd. Spk. 4" Beech South 5.27'
2. Set Spk. 16" Beech S60°W 20.73'
3. Fd. Spk. 4" Beech N40°W 21.32
4. Fd. Spk. 5" Maple N37°E 24.07'
And is accepted as a careful and faithful reestablishment of the position of the original corner.

Signed by Wayne E. Boss
Surveyor's Michigan License No. 20703

Date December 14, 1994

Charlevoix Co. Surveyor
APPROVED
Signature Wayne E. Boss
Date: Dec 14, 1994

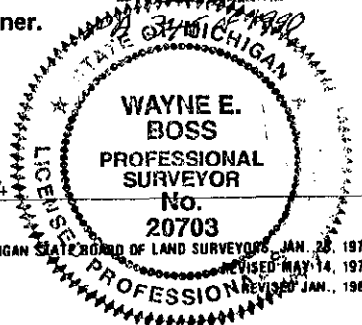

FORM APPROVED BY MICHIGAN BOARD OF LAND SURVEYORS, JAN. 28, 1971
REVISED MAY 14, 1975
REVISED JAN., 1993

LIBER 002 PAGE 316