

# SURVEY & REMONUMENTATION

2-361

## LAND CORNER RECORDATION CERTIFICATE Filing Requirement of Act 74, Mich. P.A. 1970

HUDSON Township

For corners in  
CHARLEVOIX

APR 06 1995  
COMMISSION

STATE OF MICHIGAN  
COUNTY OF CHARLEVOIX  
RECEIVED FOR RECORD

1994 DEC 22 PM 2:34

Charlotte M. Baskin  
REGISTER OF DEEDS

Register of Deeds Stamp & File Number

1. Public Land Survey Located In: 32N 4W Corner Code # C-13  
T R  
T R  
T R  
T R  
2. Property Controlling S T R  
in Section S T R  
3. Miscellaneous S T R  
Property in Sec. S T R

4. Lot No. Recorded Plat  
5. Private Claims

George J. Avendt, JR. NOV. 17 1994

I, in a field survey on 19 do hereby certify that under requirements of P.A. 74, Michigan P.A. of 1970, the corner points mentioned in lines 1 and 2 above were in conformance with regulations and rules therefore as required in the current manual of survey instructions of the United States Department of the Interior, Bureau of Land Management or by a decree of a Court of Law and/or that the corner points mentioned in lines 3, 4 and 5 above were in conformance with the rules of the Michigan Board of Land Surveyors or by a Decree of a Court of Law; established, re-established, monumented, re-monumented, recovered, found as expressed below:

NOTE: Not more than 4 corners, all in the same town and range, may be recorded on this certificate.

	A	B	C	D	E	F	G	H	I	J	K	L	M
2	6		5		4		3		2		1		
3													
4	7		8		9		10		11		12		
5													
6	13		17		16		15		14		13		
7													
8	19		20		21		22		23		24		
9													
10	30		29		28		27		26		25		
11													
12	31		32		33		34		35		36		
13													

A. Description of original monument and accessories and/or subsequent restoration:

C-13 CORNER COMMON TO SEC'S. 31 & 32, T32, R4W. & SEC'S 5 & 6, T31N, R4W.  
SURVEYED IN 1840 BY JOHN MULLETT, DS - G.L.O SET SECTION POST  
SUGAR 12" N73°E 17 LINKS (11.22') - SUGAR 10" N52°W 20 LINKS (13.2')  
SURVEYED 1972 BY CARL F. ROSER, PS 12028. FOUND 1-1/4" PIPE AT INTERSECTION OF  
ROADS N-S-E-W-. OLD SURVEY NOTES AT CHARLEVOIX COUNTY REG. OF DEEDS, FIELD BOOK  
#6, INDICATE STAKE AT ROAD CROSSING.  
10" MAPLE N64°W 37.60' - 6" MAPLE S48°W 61.70' - 12" MAPLE S52°E 43.0'  
LIBER 1, PAGE 51

B. Description of corner evidence found and/or method applied in restoring or reestablishing corner:

C-13 CORNER COMMON TO SEC'S. 31 & 32, T32, R4W. & SEC'S 5 & 6, T31N, R4W.  
FOUND SPIKE IN CENTER LINES OF GRAVEL ROADS, OVER 1-1/4 INCH PIPE 18 INCHES  
BELOW GRAVEL ROAD SURFACE.

Charlevoix Co. Surveyor

APPROVED

Signature Mary C. Avendt

Date: Dec 8, 1994


P.A. 345, 1990

C. Description of monument for corner and accessories established to perpetuate locating the position of the corner:

C-13 CORNER COMMON TO SEC'S. 31 & 32, T32, R4W. & SEC'S 5 & 6, T31N, R4W.

FOUND SPIKE IN CENTER LINES OF GRAVEL ROADS. REPLACED WITH CHARLEVOIX COUNTY  
MARKER.

N78E 82.88' 4"X4" POST & TELEPHONE RISER  
S49°E 42.88' 11" TW. MAPLE/CAP #16034  
S45°W 37.45' 10" MAPLE/CAP # 16034  
N63°W 36.70' 10" MAPLE/CAP # 16034

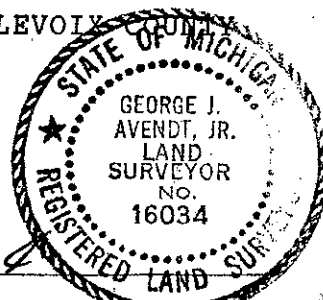

Signed by George J. Avendt, Jr.  
Surveyor's Michigan License No. 16034

Date 8 Dec 1994

FORM APPROVED BY MICHIGAN STATE BOARD OF LAND SURVEYORS, JAN. 28, 1971  
REVISED MAY 14, 1975  
REVISED JAN., 1983

LIBER 002 PAGE 361