

SURVEY &
REMONUMENTATION

OCT 18 1996

COMMISSION

LAND CORNER RECORDATION CERTIFICATE
Filing Requirement of Act 74, Mich. P.A. 1970

STATE OF MICHIGAN
COUNTY OF CHARLEVOIX
RECEIVED FOR RECORD

96 OCT 14 AM 10:22

Charles M. Cook
REGISTER OF DEEDS

For corners in

Charlevoix & Antrim
(County)

Located in:

Corner Code #

1. Public Land Survey

T32N R4W
T31N R4W
T R
T R
D-13
D-1

2. Property Controlling
in Section

S
S

T R
T R

3. Miscellaneous
Property in Sec.

S
S

T R
T R

4. Lot No. _____, Recorded Plat _____
5. Private Claims _____

I, James E. Evans, in a field survey on Nov. 7, 1995 do hereby state that under requirements of P.A. 74, Michigan P.A. of 1970, the corner points mentioned in lines 1 and 2 above were in conformance with regulations and rules therefore as required in the current manual of survey instructions of the United States Department of the Interior, Bureau of Land Management or by a decree of a Court of Law and/or that the corner points mentioned in lines 3, 4 and 5 above were in conformance with the rules of the Michigan Board of Land Surveyors or by a Decree of a Court of Law; established, re-established, monumented, recovered, found as expressed below:

NOTE: Not more than 2 corners, all in the same town and range, may be recorded on this certificate.

A. Description of original monument and accessories and/or subsequent restoration:
D-13 QUARTER CORNER COMMON TO SEC 32 T32N-R4W and SEC 5 T31N-R4W

GLO: Set post Circa 1906
16" Sugar N47°W 17 lks (11.22') E.K. Robinson Book 6
10" Sugar N82°E 32 lks (21.12') Pg 18 Set new post half way between Sec. cors
by John Mullett in 1840
Sugar 14" N59 1/2°W 45.50'
Elm 36" S64 1/2°E 58.00'
Bolt 5/8" x 18" North 33.0'

B. Description of corner evidence found and/or method applied in restoring or reestablishing corner:
No evidence of GLO found. Found bolt to be 41 ft North and 6.8 ft West of true corner


Decided to use single proration between sections corners as indicated by E. K. Robinson's notes.

GLO to C-13 = 2640' GLO to E-13 = 2640'
Meas = 2657.67' Meas = 2657.67'

C. Description of monument for corner and accessories established to perpetuate locating the position of the corner:
Set Charlevoix County cast iron monument at computed position 33 feet South of gravel road.

8" Maple S54°E 6.31' nail & cap #16034
8" Maple S03°E 10.51' nail & cap #16034
8" Maple S56°W 9.51' nail & cap #16034
9" Maple S85°W 1.32' nail & cap #16034
Found bolt N08°W 41.60'

Charlevoix Co. Surveyor
APPROVED
Signature Mary C. Feindt
Date: 10-10-96

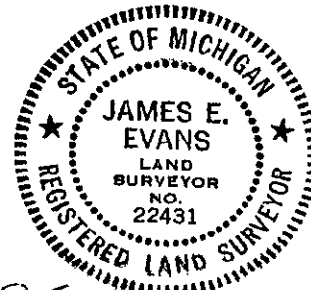

And is accepted as the best available evidence of the position of the original corner.

Signed by *James E. Evans*
Surveyor's Michigan License No. 22431

Date 10-10-96