

MAR 08 1994

COMMISSION

LAND CORNER RECORDATION CERTIFICATE  
Filing Requirement of Act 74, Mich. P.A. 1970

STATE OF MICHIGAN  
COUNTY OF CHARLEVOIX  
RECEIVED FOR RECORD

1993 DEC -9 AM 11:43

For corners in

Charlevoix  
(County)

Located in:

Corner Code #

1. Public Land Survey

T 32 NR 4 W

G-1

2. Property Controlling  
In Section

S T R

3. Miscellaneous  
Property in Sec.

S T R

4. Lot No. , Recorded Plat

5. Private Claims

Charlene M. Roser  
REGISTER OF DEEDS

Register of Deeds Stamp & File Number

I, George J. Avendt, Jr., in a field survey on October 13, 1993, do hereby certify that under requirements of P.A. 74, Michigan P.A. of 1970, the corner points mentioned in lines 1 and 2 above were in conformance with regulations and rules theretofore as required in the current manual of survey instructions of the United States Department of the Interior, Bureau of Land Management or by a decree of a Court of Law and/or that the corner points mentioned in lines 3, 4 and 5 above were in conformance with the rules of the Michigan Board of Land Surveyors or by a Decree of a Court of Law, established, re-established, monumented, re-monumented, recovered, found as expressed below:

NOTE: Not more than 4 corners, all in the same town and range, may be recorded on this certificate.

A. Description of original monument and accessories and/or subsequent restoration:

G-1 corner common to Sections 33 & 34, T33N, R4W & Sections 3 & 4, T32N, R4W

General Land Office

Set post for corner

Sugar 24" N37°E 18 links (aa.88')

Lym 20" N40°W 23 links (15.18')

by William Burt, DS - 1850

Michigan DNR

Set DNR monument

Oak 16" N58°W 8.5'

Maple 4" S54°E 24.9'

Maple 6" S40°W 6.1'

by Carl F. Roser PS 21566

on 2-7-1986

Found Michigan DNR monument

on 10-13-1993 as set by Roser

(See Reverse Side)

B. Description of corner evidence found and/or method applied in restoring or reestablishing corner:

G-1 corner common to Sections 33 & 34, T33N, R4W & Sections 3 & 4, T32N, R4W

Found Michigan DNR monument with aluminum cap and wood post as documented by Carl F. Roser, PS 21566. The witness measurements were documented from the aluminum cap (along side the wood post). The measurements checked well to face of blazes on the trees, as specified in Roser's Land Corner Recordation Certificate recorded in Liber 2, Page 193, Charlevoix County records. There was one exception. The 4" maple shown as South 54°E 24.9' was obliterated.

C. Description of monument for corner and accessories established to perpetuate locating the position of the corner:

G-1 corner common to Sections 33 & 34, T33N, R4W & Sections 3 & 4, T32N, R4W

Found Michigan DNR monument with aluminum cap with wood post along side. We accepted this as a careful and faithful reestablishment of the position of the original corner.

Witnesses - to nails & tags in trees

Maple S45°W 6.37'

Oak 17" N50°W 9.32'

Oak 15" N60°E 13.22'


Ash 10" S60°E 3.58'

Ash 15" S17°E 13.10'

Signed by George J. Avendt, Jr.

Date December 2, 1993

Surveyor's Michigan License No. 16034

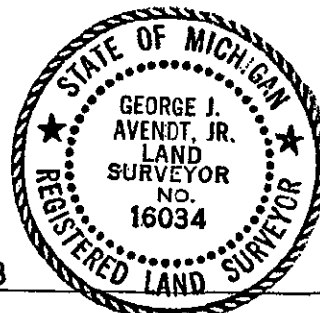

G-13 -"Recovered definite stake hole shadow with hair roots following stake hole shadow down into ground for Sec. Cor. to Sections 33 & 34 (33-4) & 3 & 4 (32-4); located from E.A. Robinson N.B.T.'s, Hemlock 36" (Hem. stp. remain's on hummock) N14½°W 40.3' & Sugar 16" (definite soft stp remain's hole), S70°E 16.3'. Fits E.A. Robinson Sur. of Sec. 34, July 1905. See notes in Jury Room at Gov't. Bldg., Chandler (33-4), pg. 33, Fd. 2" Schaaf pipe mon. (set in error) w/round conc. mon. along side (set by unknown persons) N53°51'E 82.0'. A foot trail (old logging or wagon rd., NW-SE) is West 88'±." Copied from Liber 2, Page 193, Charlevoix County records.