

For corners in

Located In:

Corner Code #

1. Public Land Survey		T <u>32N</u>	R <u>5W</u>	<u>K-8</u>
		T <u>32N</u>	R <u>5W</u>	<u>L-8</u>
2. Property Controlling in Section	S _____	T _____	R _____	_____
	S _____	T _____	R _____	_____
3. Miscellaneous Property in Sec.	S _____	T _____	R _____	_____
	S _____	T _____	R _____	_____

Register of Deeds Stamp & File Num

4. Lot No. _____, Recorded Plat _____

5. Private Claims

I, Carl T. Kiiskila, in a field survey on Feb. 09, 19 98 do hereby state that under requirements of P.A. 74, Michigan P.A. of 1970, the corner points mentioned in lines 1 and 2 above were in conformance with regulations and rules therefore as required in the current manual of survey instructions of the United States Department of the Interior, Bureau of Land Management or by a decree of a Court of Law and /or that the corner points mentioned in lines 3, 4 and 5 above were in conformance with the rules of the Michigan Board of Land Surveyors or by a Decree of a Court of Law; established, re-established, monumented, recovered, found as expressed below:

NOTE: Not more than 2 corners, all in the same town and range, may be recorded on this certificate.

	A	B	C	D	E	F	G	H	I	J	K	L
1												
2		6		5		4		3		2		1
3												
4		7		8		9		10		11		12
5												
6		18		17		16		15		14		13
7												
8		19		20		21		22		23	●	24
9												
10		30		29		28		27		26		25
11												
12		31		32		33		34		35		36

A. Description of original monument and accessories and/or subsequent restoration:

K-8 GLO set section post - William Burt, 1850.
Wit: Sugar 12" N 13° E 20 links
Hemlock 14" S 60° W 34 links

L-8 This position was not established during the original government survey.

E.A. Robinson, Dec. 1919 tied this corner while setting the center of Section 23. No new witnesses were recorded.

B. Description of corner evidence found and/or method applied in restoring or reestablishing corner:

K-8 Reestablished the east quarter corner of Section 23 by doubling over the center of section and west quarter corner of Section 23, and by prorating E.A. Robinson's recorded distance with the west half of the east-west one quarter line.

L-8 Established the center of Section 24 at the intersection of the north-south and east-west one quarter lines.


C. Description of monument for corner and accessories established to perpetuate locating the position of the corner:

K-8	Set standard DNR monument and carsonite marker post.		
Wit:	Set nail in 5" Maple	S 40° W	10.55'
	Set nail in 6" Basswood	N 26° W	5.71'
	Set nail in 4" Maple	N 55° E	21.59'
	Set nail in 3" Maple	S 53° E	27.83'

L-8 Set standard DNR monument and carsonite marker post.

Wit:	Set nail in 5" Maple	S 79° E	19.46'
	Set nail in 4" & 6" twin Maple	N 4° E	8.17'
	Set nail in 10" Basswood	N 76° W	32.03'
	Set nail in 16" Maple	S 16° W	9.33'

Signed by Carl J. Kue
 Surveyor's Michigan License No. 33981

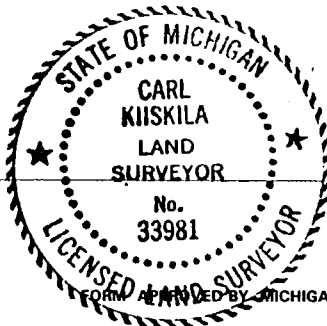

Date 7-26-79