

FEB 22 2001

SECTION

LAND CORNER RECORDATION CERTIFICATE

Filing Requirement of Act 74, Mich. P.A. 1970

STATE OF MICHIGAN
COUNTY OF CHARLEVOIX
RECEIVED FOR RECORD

96 DEC 11 PM 3:01

For corners in
Charlevoix

(County)

Located In:

Corner Code #

Charles M. Bosser
REGISTER OF DEEDS

1. Public Land Survey

T 32N R 7W

C-1 ✓

T 33N R 7W

C-13

T R

T R

T R

2. Property Controlling
in Section

S T R

S T R

3. Miscellaneous

S T R

Property in Sec.

S T R

Register of Deeds Stamp & File Number

4. Lot No. , Recorded Plat

5. Private Claims

	A	B	C	D	E	F	G	H	I	J	K	L	M
2	6	5	4	3	2	1							
3													
4	7	8	9	10	11	12							
5													
6	18	17	16	15	14	13							
7													
8	19	20	21	22	23	24							
9													
10	30	29	28	27	26	25							
11													
12	31	32	33	34	35	36							
13													

I, Wayne E. Boss, in a field survey on OCTOBER 21, 19 96, do hereby certify that under requirements of P.A. 74, Michigan P.A. of 1970, the corner points mentioned in lines 1 and 2 above were in conformance with regulations and rules therefore as required in the current manual of survey instructions of the United States Department of the Interior, Bureau of Land Management or by a decree of a Court of Law and/or that the corner points mentioned in lines 3, 4 and 5 above were in conformance with the rules of the Michigan Board of Land Surveyors or by a Decree of a Court of Law; established, re-established, monumented, re-monumented, recovered, found as expressed below:

NOTE: Not more than 4 corners, all in the same town and range, may be recorded on this certificate.

A. Description of original monument and accessories and/or subsequent restoration:

C-1 GLO JUNE 1839
JOHN HODGSON
SET POST COR. SEC. 31 & 32
T33N-R7W ALSO COR. TO
SEC. 5 & 6 T32N-R7W
1. BEECH 7 N3W 35
2. BEECH 7 N17E 49

WM. MILLER AUG. 1883
FD. COR. SET LARGE STONE
WITH MARK IN GROUND.
3. BEECH 10 S60E 15
OCT 1883 SURVEY MILLER
STATED BRG. TREE HAD BEEN
CUT BUT COR. TO SEC. 31 & 32
T33N WAS 50 LKS. EAST (SHOULD
BE SAME CORNER)

E K ROBINSON MAY 1895 FD W.MILLER
COR. APPARENTLY DIDN'T USE MEAS.
E & W, N & S AND SET NEW STAKE.
4. BEECH 8 N21 1/4 W 84 1/2 LKS.
5. SUGAR 14 N 71 1/4 W 47 LKS.

2" WELL PT. SET BY UNKNOWN. USED
BY N. DEYOUNG IN 1975 & LATER
SURVEYS. (SEE BACK)

B. Description of corner evidence found and/or method applied in restoring or reestablishing corner:

C-1 2" WELL POINT FOUND AT FENCE CORNER
8. 5" ASH N52E 3.72'
9. FENCE COR (BROKEN OFF) S15E 0.9'

Charlevoix Co. Surveyor
APPROVED
Signature Mary C. Fennell
Date: NOV 13, 1996


Description of monument for corner and accessories established to perpetuate locating the position of the corner:

C-1 T32N-R7W CORNER COMMON TO C-13 T33N-R7W.

(C-13) CHARLEVOIX CO. MON. SET

8. 5" ASH N52E 3.53' (NEW SPIKE & TAG SET)
9. FENCE COR. (BROKEN OFF) S15E 0.9'
10. 5" MAPLE N10W 19.09' SPIKE & TAG SET
11. 16" ASH S70W 6.24' SPIKE & TAG SET
12. 4" MAPLE N70W 2.55' SPIKE & TAG SET

AND IS ACCEPTED AS THE BEST AVAILABLE EVIDENCE OF THE ORIGINAL CORNER.

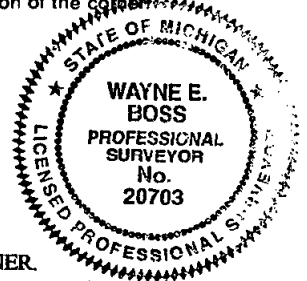

igned by

Surveyor's Michigan License No.

20703

LIBER 003

PAGE 75

Date

11/29/96

*This should have been entered in the
book twice*

SURVEY &
REMONUMENTATION

FEB 22 2001

SECTION

T32N, R7W C-1

A. con't

ALSO USED BY J. FERGUSON.

N. B. D. WIT.

6. S86W 29.80' 6" ASH

7. N8W 30.59' 5" ASH

8. N52E 3.72' 5" ASH

J.E.F. WIT.

9. FENCE COR. S15E 0.9'