

LAND CORNER RECORDATION CERTIFICATE
FILING REQUIREMENT OF ACT 74, MICH. P.A.1970

FOR CORNERS OF--	LOCATED IN--	CORNER CODE NUMBER
1. PUBLIC LAND SURVEY	T. 33 N. R. 5 W.	F-12
2. PROPERTY CONTROLLING IN SECTION	33 T. 33 N. R. 5 W.	2.8
3. MISCELLANEOUS PROPERTY IN SECTION	33 T. 33 N. R. 5 W.	654.6' N. of G-12
4. LOT NO.	RECORDED PLAT	
5. PRIVATE CLAIMS		

REGISTER OF DEEDS STAMP AND
FILING NUMBER

I, Carl F. Roser, do hereby certify that under requirements of P.A. 74, Michigan P.A. of 1970, the corner points mentioned in lines 1 and 2 above were, in a field survey on October 7, 1981, established, re-established, monumented, re-monumented, recovered or restored as expressed below and in conformance with regulations and rules therefore as required in the current manual of survey instructions of the United States Department of the Interior, Bureau of Land Management or by a decree of a court of law. Furthermore, that the corner points mentioned in lines 3, 4 and 5 above were, in a field survey on September 29, 1981, found, recovered, restored, established or re-established as expressed below and in conformance with the rules of the Michigan State Board of Registration for Land Surveyors or, by a Decree of a Court of law:

XX
C. Continued:

F-12
Fd, old 1" angle iron bed rail
7" Apple N05°W 45.61
13" Maple N36°E 25.87
7" Maple S38°E 57.20

B. Description of corner evidence found and/or method applied in restoring or re-establishing corner:
654.6' N. of G-12 Estab. NE cor. of S1/2-S1/2-NE1/4 of Sec 33 per std. B.L.M. instructions.
2 Estab. 1/8 cor. (NE cor. of NW1/4-NE1/4 of Sec. 33) midway & on line between NE & N1/4 corners of Sec. 33. Corner is in line with fence to South.
8 Recovered angle iron for NE cor. of W1/2-SW1/4 of Sec. 33 per E.A. Robinson survey 1915; "Melrose" Pgs. 91-94.
F-12 Recovered angle iron bed rail for center of Sec. 33 per E.A. Robinson, Nov. 1915; as noted in Red Field Book "Melrose", Pgs. 91 to 94: notes in jury room at Co. Ct. Hse. Corner is buried 1 ft. in E-W trail road.

C. Description of monument for corner and accessories established to perpetuate locating the position of the corner:
654.6' N. of G-12
Set 5/8" x 36" rerod w/RLS cap & ced. post w/loc tag.
3" Maple S60°W 20.0
4" Maple N15°E 35.5
5" Maple N70°E 47.6
2 Drove 5/8" x 2 1/2 rerod w/RLS cap in ctr. E-W gravel rd
5" Cedar S10°E 74.7
3" W. Birch (clump S70°E 78.7
ctr. of R.R. tracks W 349.3'
Fd. 1/2" rerod S03°E 32.25
Put loc tag on R.R. tie cor. fn. post S 32'
8 Fd. 1" angle ir. w/rocks around & added ced. post w/loc tag.
10" Maple Due E. 26.8
9" Maple S25°E 14.7
4" Maple (cluster) S15°W 15.2


SIGNED BY Carl F. Roser 01-12-82 DATE

SURVEYOR'S MICHIGAN REGISTRATION NO. 12028

FOR STATE AND UNITED STATES AGENCIES:

SIGNED BY _____ DATE _____
CHIEF OF SURVEY PARTY

APPROVED AND SIGNED BY _____ DATE _____
MICHIGAN REGISTERED LAND SURVEYOR

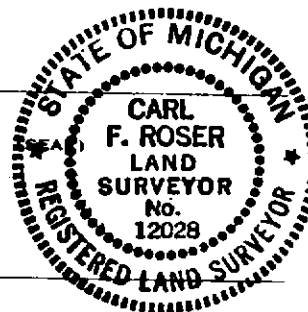

SURVEYOR'S MICHIGAN REGISTRATION NO. _____

MELROSE TOWNSHIP
CHARLEVOIX COUNTY