

MICHIGAN  
DEPARTMENT OF CONSERVATION  
FORESTRY DIVISION

# LAND CORNER RECORD

T. 33 N.R. 7 W  
T. 33 N.R. 8 W


Charlevoix COUNTY

DESCRIPTION OF CORNER Meander corner common to Sections 24 and 19

CORNER MONUMENT Set 2" x 40" pipe filled with concrete and brass cap 6" above grd.

DATE MONUMENT PLACED AND WITNESSED 12/4/67

WITNESSES TO CORNER.....

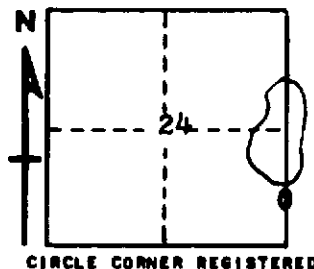

CIRCLE CORNER REGISTERED

6" Cedar	S 43° 30' W	47.80'
6" Cedar	S 20° 30' E	54.40'
5" Cedar	S 53° 30' E	42.30'

AND

DESCRIPTION IN DETAIL AS TO HOW CORNER WAS LOCATED AND IDENTIFIED OR RESTORED.

Found old crooked fence line N & S.

SURVEYOR'S SEAL

*Gregory A. Shadko*  
SIGNED GREGORY A. SHADKO DATE 12/12/67  
REGISTERED LAND SURVEYOR # 130068  
# 1934