

SURVEY & REMONUMENTATION

FEB 04 1999

STATE OF MICHIGAN
COUNTY OF CHARLEVOIX
RECEIVED FOR RECORD

98 NOV 13 PM 3:51

SECTION

LAND CORNER RECORDATION CERTIFICATE Filing Requirement of Act 74, Mich. P.A. 1970

For corners in
CHARLEVOIX TWP.
CHARLEVOIX

(County)

Located In:

Corner Code #

1. Public Land Survey T 34N R 8W H-11
T R
T R
T R
2. Property Controlling S T R
in Section S T R
3. Miscellaneous S T R
Property in Sec. S T R
4. Lot No. , Recorded Plat
5. Private Claims

I, James E. Evans, in a field survey on Aug 27, 1998 do hereby state that under requirements of P.A. 74, Michigan P.A. of 1970, the corner points mentioned in lines 1 and 2 above were in conformance with regulations and rules therefore as required in the current manual of survey instructions of the United States Department of the Interior, Bureau of Land Management or by a decree of a Court of Law and /or that the corner points mentioned in lines 3, 4 and 5 above were in conformance with the rules of the Michigan Board of Land Surveyors or by a Decree of a Court of Law; established, re-established, monumented, recovered, found as expressed below:

NOTE: Not more than 2 corners, all in the same town and range, may be recorded on this certificate.

A. Description of original monument and accessories and/or subsequent restoration: H-11 Quarter Corner common to sections 27 & 34 T34N - R8W

GLO 6" Hemlock is Quarter Corner
Ch. W. Cathart DS 10-22-1841

Lawrence R. Feindt PS #21566 7-20-76
Found 1" solid rod
1) Power pole S53°30'W 107.73'
2) Power pole S04°00'W 33.98'
3) 22" Maple S57°20'W 72.09'

Wayne Boss PS #20703 4-19-77
Found T-iron & cap #3920
1) Utility pole S55°W 107.70'
2) Utility pole S5°W 33.87'
3) 24" Maple N55°W 72.10'

Sherman Chamberlain PS #25834 2-9-79 Found T-iron Same witnesses as LRF
Sherman Chamberlain PS #25834 7-18-85 Found 1" solid rod Same witnesses as above
George Avendt PS #16034 1-17-90 Found 1" solid rod Same witnesses as above
Mary C Feindt PS #3920 7-14-93 Found T-iron 1) Power pole S53°30'W 107.73'
3) 22" Maple N57°20'W 72.09'
4) Fire Hydrant N20°E 54.95'
5) Fence post S10°E 40.01'

Charlevoix Co. Surveyor
APPROVED
Signature Mary C. Feindt
Date: Oct 8, 1998

B. Description of corner evidence found and/or method applied in restoring or reestablishing corner: H-11 Quarter Corner common to sections 27 & 34 T34N - R8W

Found 1" solid rod under asphalt in intersection of Carpenter Ave. & Norwood Road
Distance to H-10: Record = 2669.44' Meas = 2671.28 ft
Distance to I-11: Record = 2645.75 ft Meas = 2645.98 ft
Distance to H-12: Ranger = 2648.90 ft Meas = 2648.85 ft

C. Description of monument for corner and accessories established to perpetuate locating the position of the corner: H-11 Quarter Corner common to sections 27 & 34 T34N - R8W

Replaced 1" rod with Charlevoix County monument in monument box.
witnesses: 1) Power pole S56°W 107.51' Found nail in NE side #3920
3) 24" Maple N55°W 72.09' Set nail and tag in South side
4) Center top fire hydrant N20°E 54.97'
5) Steel fence post S11°E 40.02'


AND IS ACCEPTED AS A CAREFUL AND FAITHFUL PERPETUATION OF THE POSITION OF THE ORIGINAL CORNER.

Signed by James E. Evans

Date 10-8-98

Surveyor's Michigan License No. 22431

L100P 003 PAGE 198

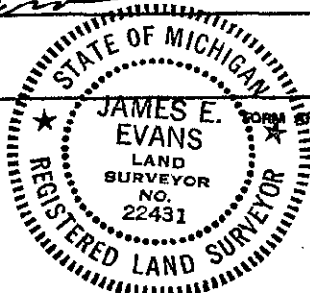

APPROVED BY MICHIGAN STATE BOARD OF PROFESSIONAL SURVEYORS, JAN. 28, 1971
REVISED MAY 14, 1975
REVISED JAN., 1983
REVISED OCT., 1996