

FEB 04 1999

SECTION

STATE OF MICHIGAN
COUNTY OF CHARLEVOIX
REGISTER OF DEEDS

98 DEC 28 PM 12:22

LAND CORNER RECORDATION CERTIFICATE

Filing Requirement of Act 74, Mich. P.A. 1970

For corners in

<u>Charlevoix</u> (County)	Located in:	Corner Code #
1. Public Land Survey	<u>T4N R 8W</u>	<u>J-8</u>
	T <u> </u> R <u> </u>	<u> </u>
	T <u> </u> R <u> </u>	<u> </u>
	T <u> </u> R <u> </u>	<u> </u>
2. Property Controlling in Section	S <u> </u> T <u> </u> R <u> </u>	<u> </u>
	S <u> </u> T <u> </u> R <u> </u>	<u> </u>
3. Miscellaneous Property in Sec.	S <u> </u> T <u> </u> R <u> </u>	<u> </u>
	S <u> </u> T <u> </u> R <u> </u>	<u> </u>

Charlevoix Co. Surveyor
REGISTER OF DEEDS

Register of Deeds Stamp & File Number

4. Lot No. _____, Recorded Plat _____
5. Private Claims _____

I, Wayne E. Boss NOV 98
in a field survey on _____, 19____ do hereby state that under requirements of P.A. 74, Michigan P.A. of 1970, the corner points mentioned in lines 1 and 2 above were in conformance with regulations and rules therefore as required in the current manual of survey instructions of the United States Department of the Interior, Bureau of Land Management or by a decree of a Court of Law and/or that the corner points mentioned in lines 3, 4 and 5 above were in conformance with the rules of the Michigan Board of Land Surveyors or by a Decree of a Court of Law; established, re-established, monumented, recovered, found as expressed below:

NOTE: Not more than 2 corners, all in the same town and range, may be recorded on this certificate.

A	B	C	D	E	F	G	H	I	J	K	L	M
	5		5		4		3		2		1	
3												
4	7		8		9		10		11		12	
5												
6	18		17		16		15		14		13	
7												
8	19		20		21		22		23		24	
9												
10	30		29		28		27		26		25	
11												
12	31		32		33		34		35		36	
13												

A. Description of original monument and accessories and/or subsequent restoration:

J-8 CORNER NOT ESTABLISHED BY AUG. 1, 1912, E.A. ROBINSON GOVERNMENT LAND OFFICE FD. NETTLETON CORNER & ABOUT 1880, D.C. NETTLETON DIXON CORNER, FIELD NOTES PLACED CORNER 2592.5' WEST OF DO NOT INDICATE WHAT HE USED. OF EAST 1/4 CORNER NOTES DO INDICATE DISTANCE BEFORE 1880, JOSEPH DIXON PLACED TO CENTERLINE OF MT. MCSAUBA IRON 2640' WEST OF EAST 1/4 CORNER ROAD OF 526.8'. ABOUT 1976 UNKNOWN SURVEYOR FOUND 5/8" ROD 6" CEDAR SOUTH 35.45'. UTILITY POLE S48*E 40.69'. 14" OAK N64*E 57.60'

1974 RICHARD BIDSTRUP FOUND 5/8" ROD IN ROAD NE COR. OF HOUSE S60*W 86.30' NW COR. OF PORCH S45*E 83.60' SW COR. OF GARAGE N10*E 102.60' JUNE 1981, S.A. CHAMBERLAIN FD. 5/8" ROD, AND BIDSTRUP WITNESSES


B. Description of corner evidence found and/or method applied in restoring or reestablishing corner:

J-8 OCTOBER 1998 FOUND PK NAIL IN SURFACE OF ASPHALT ROAD OVER 5/8" ROD NE CORNER OF HOUSE S60*W 86.30' NW CORNER OF PORCH S45*E 83.60' SW CORNER OF GARAGE N10*E 102.60' 6" CEDAR SOUTH 35.45' FOUND NAIL & 2" DISK UTILITY POLE S48*E 40.69' FOUND NAIL & 2" DISK 14" OAK N64*E 57.60' FOUND NAIL J-8 TO K-8 RECORDS SHOW 2592.5' AND 2592.35' MEASURES 2592.33' J-8 TO J-9 NO PREVIOUS RECORD FOUND, MEASURES 1157.54'

Charlevoix Co. Surveyor
APPROVED
Signature Wayne E. Boss
Date: Dec 24 1998

C. Description of monument for corner and accessories established to perpetuate locating the position of the corner:

J-8 PLACED HARRISON MONUMENT AND CAST IRON MONUMENT BOX NE CORNER OF HOUSE S60*W 86.30', NW CORNER OF PORCH S45*E 83.60' SW CORNER OF GARAGE N10*E 102.60' 6" CEDAR SOUTH 35.45' SET NAIL & TAG UTILITY POLE S48*E 40.69' SET NAIL & TAG 14" OAK N64*E 57.60' SET NAIL & TAG CORNER HAS BEEN USED AND ACCEPTED AS BEST POSSIBLE LOCATION OF CENTER OF SECTION

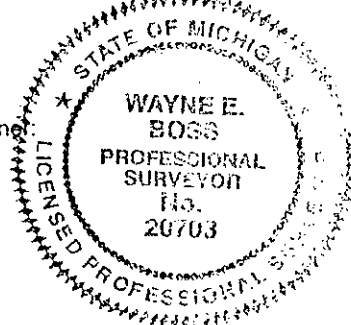

Signed by *Wayne E. Boss*
Surveyor's Michigan License No. 20703

Date 12/24/98