

SECTION

LAND CORNER RECORDATION CERTIFICATE
Filing Requirement of Act 74, Mich. P.A. 1970

STATE OF MICHIGAN
COUNTY OF CHARLEVOIX
RECEIVED FOR RECORD

00 DEC 21 PM 2:08

Charles M. Justice
REGISTER OF DEEDS

Register of Deeds Stamp & File Number

For corners in

Charlevoix Located In: Corner Code #
(County)

1. Public Land Survey T 33N R 8W E-1
T R
T 34N R 8 E-13 ✓
T R
2. Property Controlling S T R
in Section S T R
3. Miscellaneous S T R
Property in Sec. S T R

4. Lot No. , Recorded Plat

5. Private Claims

I, Wayne E. Boss, in a field survey on November, 2000 do hereby state that under requirements of P.A. 74, Michigan P.A. of 1970, the corner points mentioned in lines 1 and 2 above were in conformance with regulations and rules therefore as required in the current manual of survey instructions of the United States Department of the Interior, Bureau of Land Management or by a decree of a Court of Law and for that the corner points mentioned in lines 3, 4 and 5 above were in conformance with the rules of the Michigan Board of Land Surveyors or by a Decree of a Court of Law; established, re-established, monumented, recovered, found as expressed below:

NOTE: Not more than 2 corners, all in the same town and range, may be recorded on this certificate.

A. Description of original monument and accessories and/or subsequent restoration:

E-1 June 5, 1840 John Mullett
Set section corner post
1) Cedar 14" N52° W 32 links (15.18')
2) Cedar 10" N 58° E 21 links (13.86')

October 22, 1840 Charles W. Cathcart
Found post
4) Balsam 4" S28° E 12 links (7.92')
5) Alder 4" S 20° W 32 links (15.18)
3) Cedar 20" S 05° W 25 links (16.5')

1880 Joseph Dixon
Found post

1959 M.C. Feindt, P.S.
Found pipe
6) 5" Cedar North 16.53"
7) 4" Cedar N 50° E 21.98'
8) 3" Cedar S40° E 12.63'

August 12, 1975
also in 1985 N.B. Deyoung, P.S.
Found 2" pipe
9) 6" Cedar S45° W 41.20'
10) 5" Cedar N10° W 32.40'

October 22, 1976
L.R. Feindt, RLS
Found 1 1/2" pipe
7) 6" Cedar N 50° E 22.11'
6) 6" Cedar North 16.5'
8) 5" Cedar S 55° E 12.65'

October 1995 Terry E. Brand
Found 1 1/2" pipe
Raised to surface with 3/4" pipe
TEB set new corner (1 1/2" pipe) at found Cedar post
S 75° 26' E 4.74
Recorded on LCRC in Liber 003, Page 05.

1997 John E. Ferguson
Used pipe as found

B. Description of corner evidence found and/or method applied in restoring or reestablishing corner:

E-1 November 7, 2000
Found 1" o.d. pipe (New TEB corner not found)
6) 7" Cedar North 16.53' found nail and cap 21566
7) 6" Cedar N 50° E 21.98 found nail and cap 3920
8) 5" Cedar S40° E 12.63 found nail and cap 3920
9) 6" Cedar S45° W 41.20' found nail, no cap
11) 1/2" iron South 28.30 cap 20705
12) 1/2" iron East 239' cap 24595

E-2 to E-1 GLO 39 chains (2574') measures 2586.30'
E-1 to F-1 GLO 40 chains (2640') measures 2661.39' MCF
E-1 to D-1 GLO 40 chains (2640') measures 2639.9'


C. Description of monument for corner and accessories established to perpetuate locating the position of the corner:

E-1 Placed Charlevoix County steel monument
6) 7" Cedar North 16.53' found nail and cap 21566
7) 6" Cedar N 50° E 21.98 found nail and cap 3920
8) 5" Cedar S40° E 12.63 found nail and cap 3920
10) 6" Cedar S45° W 41.20' found nail, no cap
11) 1/2" iron South 28.30 cap 20705
12) 1/2" iron East 239' cap 24595

And is accepted as a careful and faithful reestablishment of the position of the original corner.

Signed by Wayne E. Boss
Surveyor's Michigan License No. 20705

Date 12/21/2000

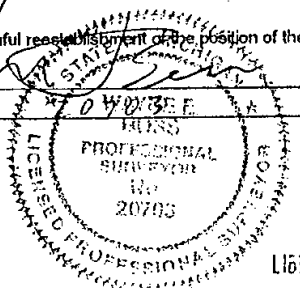

Charlevoix Co. Surveyor
APPROVED
Signature Mary C. Feindt
Date 12/21/00