

SURVEY & REMONUMENTATION

FEB 02 1999

SECTION

LAND CORNER RECORDATION CERTIFICATE
Filing Requirement of Act 74, Mich. P.A. 1970

Approved By Delta County
Land Survey Remonumentation
Peer Group Under Act 345 Of
P.A. Of 1990 On December 30, 1998

Philip Blumling
Chairman

For corners in

DELTA
(County)

Located In:

Corner Code #

- | | | |
|------------------------------------|-------------------------|-----------------|
| 1. Public Land Survey | T 40 N R 19 W | MC I-4/5 (19) ✓ |
| | T 40 N R 19 W | MC L/M-1 |
| | T 41 N R 18 W | MC L/M-13 |
| | T _____ R _____ | _____ |
| 2. Property Controlling in Section | S _____ T _____ R _____ | _____ |
| | S _____ T _____ R _____ | _____ |
| 3. Miscellaneous Property in Sec. | S _____ T _____ R _____ | _____ |
| | S _____ T _____ R _____ | _____ |

Received Jan 11 1999
9:45 AM
Liber 9 Page 134
Walter C. Thies
Delta County, MI Reg. of Deeds

Register of Deeds Stamp & File Number

4. Lot No. _____, Recorded Plat _____
5. Private Claims _____
I-4/5 [MC SEC'S 10/11] L/M-1 & L/M-13 SAME COR [MC SEC 32 T41N R18W & SEC 1 T40N R19W]

	A	B	C	D	E	F	G	H	I	J	K	L	M
2	6	5	4	3	2	1							
3													
4	7	8	9	10	11	12							
5													
6	18	17	16	15	14	13							
7													
8	19	20	21	22	23	24							
9													
10	30	29	28	27	26	25							
11													
12	31	32	33	34	35	36							
13													

I, M.P. DAVIS, in a field survey on DECEMBER, 19 98, do hereby certify that under requirements of P.A. 74, Michigan P.A. of 1970, the corner points mentioned in lines 1 and 2 above were in conformance with regulations and rules therefore as required in the current manual of survey instructions of the United States Department of the Interior, Bureau of Land Management or by a decree of a Court of Law and/or that the corner points mentioned in lines 3, 4 and 5 above were in conformance with the rules of the Michigan Board of Land Surveyors or by a Decree of a Court of Law; established, re-established, monumented, re-monumented, recovered, found as expressed below:

NOTE: Not more than 4 corners, all in the same town and range, may be recorded on this certificate.

A. Description of original monument and accessories and/or subsequent restoration:


I-4/5 [MC SEC'S 10/11] A. MERRYWEATHER, D.S. - 1848 - WOOD POST - (WILLOW 04°-S61°W-64 LINKS)
M.S. McNABB - 1921 - FIELD NOTES OF SUBDIVISION OF SEC 11 SHOWS MC IN PLACE 495' SOUTH OF THE S1/16 COR ON LINE BETWEEN SEC'S 10 & 11 NO WIT'S NOTED OR DESCRIPTION OF THE MONUMENT GIVEN.

L/M-1 [MC NORTH LINE SEC 1] JOHN BURT, D.S. - 1845 - WOOD POST (W.ASH 08°-N37°W-35 LINKS) (B.ASH 07°-N32°W-46 LINKS)
NO RECORD EVIDENCE OF SUBSEQUENT CORNER RECOVERY AND/OR MONUMENTATION.

B. Description of corner evidence found and/or method applied in restoring or reestablishing corner:

I-4/5 [MC SEC'S 10/11] NO CORNER EVIDENCE FOUND. ID THE W1/4 COR OF SEC 11 & McNABB'S S1/16 ON THE WEST LINE OF SEC 11. EXTENDED A LINE SOUTH FROM THE 1/4 COR THRU THE S1/16 COR AND ESTABLISHED THE MC ON THIS LINE AT "GLO" DISTANCE SOUTH OF THE 1/4 CORNER.

L/M-1 [MC N LINE SEC 1 T40N R19W] NO CORNER EVIDENCE FOUND. REESTABLISHED THE CORNER POSITION ON THE 4TH CORRECTION LINE NORTH, BEING ON LINE WITH THE SW CORNER OF SEC 32 & THE S1/4 COR OF SEC 34 T41N R18W AND AT THE "GLO" DISTANCE EAST OF THE SW CORNER OF SEC 32. AS THERE WAS FOUND TO BE A 2 CHAIN SHORTAGE IN THE DISTANCE BETWEEN THE CONTROL CORNERS, BELIEVED TO HAVE OCCURED IN THE "GLO" CROSSING OF LITTLE BAY DE NOC, IT WAS DECIDED TO HOLD THE "GLO" DISTANCE EAST OF THE SW CORNER OF SEC 32 AS IT GIVES THE BEST FIT TO THE PRESENT SHORE LINE.

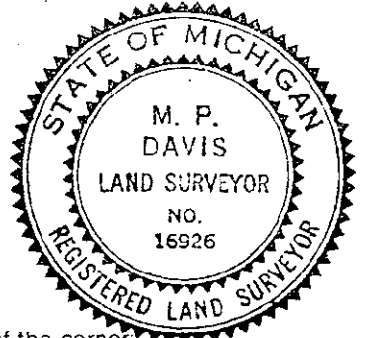

C. Description of monument for corner and accessories established to perpetuate locating the position of the corner:

I-4/5 SET A BERNTSEN A1NB30 ALUM MONUMENT W/A 3 1/4" CAP STAMPED TO ID THE CORNER POSITION.
ASH 05" SURVEY MONUMENT SIGN POST NOTE: OPEN MARSH LAND SURROUNDS THE
S54°E NORTH CORNER POSITION. NO OTHER WIT'S
27.69' 46.24' 0.90' (TO FACE) AVAILABLE.

L/M-1 SET BERNTSEN A1NB30 ALUMN MON. W/A 3 1/4" CAP STAMPED TO ID THE CORNER POSITION.
ASH 08" SURVEY MONUMENT SIGN POST
N44°W EAST
62.46' 37.51' 1.22' (TO FACE)

NOTE: BEARINGS TO REFERENCE OBJECTS ARE MAGNETIC-DISTANCES ARE TO A NAIL W/A DELTA COUNTY REFERENCE TAG, UNLESS OTHERWISE NOTED.

Signed by M.P. Davis Date 12/29/98

Surveyor's Michigan License No. 16926