

SURVEY & REMONUMENTATION

JAN 14 1998

SECTION

LAND CORNER RECORDATION CERTIFICATE
Filing Requirement of Act 74, Mich. P.A. 1970

Approved By Delta County
Land Survey Remonumentation
Peer Group Under Act 345 Of
P.A. Of 1990 On 12/18, 1997

Robert Schueler
Acting Chairman

For corners in
DELTA
(County)

Located In: Corner Code ##

- | | | | |
|------------------------------------|---|-------------|------------------|
| 1. Public Land Survey | T | 41 N R 23 W | MC C/D-5 LT BANK |
| | T | 41 N R 23 W | MC C/D-7 RT BANK |
| | T | R | # 7 |
| | T | R | |
| 2. Property Controlling in Section | S | T R | |
| | S | T R | |
| 3. Miscellaneous Property in Sec. | S | T R | |
| | S | T R | |

Recorded Dec 19 1997
at 9:00 am
Book 8 Page 251
Robert Schueler
Acting Chairman

Register of Deeds Stamp & File Number

4. Lot No. _____, Recorded Plat _____
5. Private Claims C/D-5 MC ON LT BANK ESC RIV C/D-7 MC ON RT BANK ESC RIV

	A	B	C	D	E	F	G	H	I	J	K	L	M
2	6	5	4	3	2	1							
3													
4	7	8	9	10	11	12							
5		•											
6	18	17	16	15	14	13							
7		•											
8	19	20	21	22	23	24							
9													
10	30	29	28	27	26	25							
11													
12	31	32	33	34	35	36							
13													

I, M.P. DAVIS, in a field survey on 17 JUNE, 1997, do hereby certify that under requirements of P.A. 74, Michigan P.A. of 1970, the corner points mentioned in lines 1 and 2 above were in conformance with regulations and rules therefore as required in the current manual of survey instructions of the United States Department of the Interior, Bureau of Land Management or by a decree of a Court of Law and/or that the corner points mentioned in lines 3, 4 and 5 above were in conformance with the rules of the Michigan Board of Land Surveyors or by a Decree of a Court of Law; established, re-established, monumented, re-monumented, recovered, found as expressed below:


NOTE: Not more than 4 corners, all in the same town and range, may be recorded on this certificate.

A. Description of original monument and accessories and/or subsequent restoration:
C/D-5 [MC LT BANK]- A.MERRYWEATHER, D.S. - 1847 - Y. PINE 22" CORNER TREE (NO OTHER WIT'S NOTED)
M.S. McNABB-1945-SET IRON PIPE ON BANK OF RIVER (NO WIT'S NOTED)

C/D-7 [MC RT BANK]- A.MERRYWEATHER, D.S. - 1847 - CEDAR 12"-CORNER TREE (NO OTHER WIT'S NOTED)
M.S. McNABB-1947-SET IRON BOLT AT TOP OF BANK (NO WIT'S NOTED)

B. Description of corner evidence found and/or method applied in restoring or reestablishing corner:
C/D-5 [REF MON TO MC ON LT BANK] FOUND IN PLACE AT EDGE OF UPLAND VEGETATION McNABB'S 1945 IRON PIPE, ID EXISTING MONUMENT BY MEASUREMENTS TO ADJOINING CORNERS WHICH CHECK WELL WITH THE RECORDS OF McNABB. EXISTING MONUMENT WAS FOUND TO BE 0.72' NORTH OF LINE BETWEEN CORNERS, CORRECTED SOUTH TO TRUE LINE.

C/D-7 [REF MON TO MC ON RT BANK] FOUND IN PLACE, AT TOP OF RIVER BANK, McNABB'S IRON BOLT. ID CORNER POSITION BY RECORD DISTANCE WEST TO McNABB'S 1/16 COR & SEC COR WHICH CHECKS WELL. EXISTING MONUMENT WAS FOUND TO BE 0.82' SOUTH OF LINE BETWEEN CORNERS, CORRECTED NORTH TO TRUE LINE.

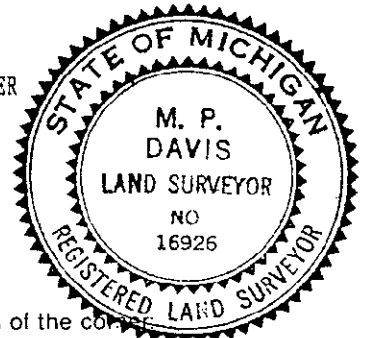

C. Description of monument for corner and accessories established to perpetuate locating the position of the corner:
C/D-5 [LT BANK] SET 5/8"x18" REBAR W/A 3 1/4" ALUM CAP STAMPED TO ID THE CORNER POSITION.
MAPLE 12" MAPLE 10" W. PINE 09" LEFT BANK ESCANABA RIVER SURVEY MONUMENT SIGN POST
N62°E S14°W S62°E WEST NORTH
18.25' 14.13' 43.25' 13' 1.53' (TO FACE)

C/D-7 [RT BANK] SET 5/8"x18" REBAR W/A 3 1/4" ALUM CAP STAMPED TO ID THE CORNER POSITION.
BALSAM 08" BALSAM 05" CEDAR 11" RIGHT BANK ESCANABA RIVER
N43°W S30°W WEST EAST
27.74' 32.86' 11.80' 40'

NOTE: BEARINGS TO REFERENCE OBJECTS ARE MAGNETIC & DISTANCES ARE TO A NAIL IN THE CENTER OF THE OBJECT, UNLESS OTHERWISE NOTED.

Signed by M.P. Davis Date 11/28/97
Surveyor's Michigan License No. 16926