

RECORDED

LAND CORNER RECORDATION CERTIFICATE
Filing Requirement of Act 74, Mich. P.A. 1970

1997 OCT -9 AM 8 20

For corners in
Dickinson
 (County)

Located In:

Corner Code #

Waucedah Twp.

REGISTER OF DEEDS
 DICKINSON COUNTY
 RON MCHESNEY

1. Public Land Survey	T	39N	R	28W	F-3
	T		R		K-2
	T		R		
	T		R		
2. Property Controlling in Section	S		T	R	
	S		T	R	
3. Miscellaneous	S		T	R	
Property in Section	S		T	R	

Register of Deeds Stamp & File Number

4. Lot No. _____, Recorded Plat _____
 5. Private Claims _____

I, Robert F. Perkins, in a field survey on June 26, 1997
 do hereby certify that under requirements of P.A. 74, Michigan P.A. of 1970, the corner points mentioned in lines 1 and 2 above were in conformance with regulations and rules therefore as required in the current manual of survey instructions of the United States Department of the Interior, Bureau of Land Management or by a decree of a Court of Law and/or that the corner points mentioned in lines 3, 4 and 5 above were in conformance with the rules of the Michigan Board of Professional Surveyors or by a Decree of a Court of Law; established, re-established, monumented, re-monumented, recovered, found as expressed below:

NOTE: Not more than 4 corners, all in the same town and range, may be recorded on this certificate.

	A	B	C	D	E	F	G	H	I	J	K	L	M
2	6	5				4	3			2			
3													
4	7	8				9	10			11			
5													
6	18	17				16	15			14			
7													
8	19	20				21	22			23			
9													
10	30	29				28	27			26			
11													
12	31	32				33	34			35			
13													

A. Description of original monument and accessories and/or subsequent restoration:

F-3 South $\frac{1}{4}$ Corner, Section 4
 Post by James Mullett, D.S. 1849
 Original Bearing Trees
 Cedar 8" N38°W 03 Lks.
 B.Ash 6" S59°W 11 Lks.

K-2 East $\frac{1}{4}$ Corner, Section 2
 Post by James Mullett, D.S. 1849
 Original Bearing Trees
 Fir 10" N33°E 22 Lks.
 Cedar 12" S89°E 10 Lks.

B. Description of corner evidence found and/or method applied in restoring or reestablishing corner:

F-3 No evidence of Original Corner or Accessories Found.
 Found 2 $\frac{1}{2}$ " Sq. Cedar Post with remains of very old fences South and East from Post.
 Post agrees with Survey by H.F. Mills, E.M. made in 1922.
 Map on File at W.E.P.Co. Iron Mtn. Office

K-2 Found K.C. Corp. B.C. Pipe Marker as Set by E. Kazianka, P.S. #14765 in 1966.
 For Details refer to old Certificate #1041 on file at Dickinson County Register of Deeds Office.

ACCEPTED BY THE DICKINSON COUNTY
 SURVEY PEER GROUP AS THE OFFICIAL
 CORNER UNDER MICHIGAN PUBLIC ACT
 345 OF 1990 AT A MEETING HELD ON
 10-7-97

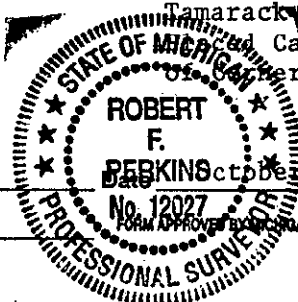
R.F.P.

COUNTY REPRESENTATIVE

C. Description of monument for corner and accessories established to perpetuate locating the position of the corner:

F-3 Accepted above Post as Best Available Evidence of Corner Location. Set 2 $\frac{1}{2}$ " D.C. Remon. Corner at Post.
 New Witnesses
 Spruce 12" N08°E (M.B.) 38.70'
 Db1. Cedar 12" N63°E (M.B.) 10.00'
 Cedar 10" S67°E (M.B.) 17.00'
 Fir 3" S35°W (M.B.) 20.30'
 Placed Carsonite Marker 1.0' North.

K-2 Upgraded above Pipe Monument as follows:
 New Witnesses
 Db1. Fir 10" N03°E (M.B.) 24.38'
 Tamarack 8" N55°W (M.B.) 14.33' (Ex.
 Tamarack 8" N80°W (M.B.) 9.6' (Ex.
 Tamarack 10" S68°E (M.B.) 17.44' (Ex.
 Placed Carsonite Marker 1.5' North

Signed by Robert F. PerkinsSurveyor's Michigan License No. 12027Date October 1, 1997

FORM APPROVED BY MICHIGAN STATE BOARD OF PROFESSIONAL SURVEYORS, JAN. 28, 1971
 REVISED MAY 14, 1975
 REVISED JAN., 1983