

40N 29W H1
40N 29W I1

LAND CORNER RECORDATION CERTIFICATE
Filing Requirement of Act 74, Mich. P.A. 1970

RECORDED
1999 NOV 30 PM 3:31

For corners in

DICKINSON
(County)
NORWAY TOWNSHIP

Located In:

Corner Code #

1. Public Land Survey T 41 N R 29 W H-13
T 41 N R 29 W I-13
T R
T R
2. Property Controlling S T R SURVEY &
in Section S T R MONUMENTATION
3. Miscellaneous S T R
Property in Sec. S T R
MAR 24 2000

REGISTER OF DEEDS
DICKINSON COUNTY
RON MOORE, CLERK

Register of Deeds Stamp & File
Number

4. Lot No. , Recorded Plat SECTION
5. Private Claims

I, JAMES H. MOORE, in a field survey on SEPTEMBER 9 & OCTOBER 13, 19 99 do hereby state that under requirements of P.A. 74, Michigan P.A. of 1970, the corner points mentioned in lines 1 and 2 above were in conformance with regulations and rules therefore as required in the current manual of survey instructions of the United States Department of the Interior, Bureau of Land Management or by a decree of a Court of Law and for that the corner points mentioned in lines 3, 4 and 5 above were in conformance with the rules of the Michigan Board of Land Surveyors or by a Decree of a Court of Law; established, re-established, monumented, recovered, found as expressed below:

| | A | B | C | D | E | F | G | H | I | J | K | L | M |
|----|----|---|----|---|----|---|----|---|----|---|----|---|---|
| 1 | | | | | | | | | | | | | |
| 2 | 6 | | 5 | | | 4 | | 3 | | 2 | | 1 | |
| 3 | | | | | | | | | | | | | |
| 4 | 7 | | 8 | | 9 | | 10 | | 11 | | 12 | | |
| 5 | | | | | | | | | | | | | |
| 6 | 13 | | 17 | | 16 | | 15 | | 14 | | 12 | | |
| 7 | | | | | | | | | | | | | |
| 8 | 19 | | 20 | | 21 | | 22 | | 23 | | 24 | | |
| 9 | | | | | | | | | | | | | |
| 10 | 30 | | 29 | | 28 | | 27 | | 26 | | 25 | | |
| 11 | | | | | | | | | | | | | |
| 12 | 31 | | 32 | | 33 | | 34 | | 35 | | 36 | | |
| 13 | | | | | | | | | | | | | |

NOTE: Not more than 2 corners, all in the same town and range, may be recorded on this certificate.

A. Description of original monument and accessories and/or subsequent restoration:

H-13 SOUTH 1/4 CORNER OF SECTION 34
FOUND 10" CEDAR PER AUSTIN BURT, D.S. 1846
USED 10" CEDAR AS CORNER
NO WITNESSES SET

I-13 CORNER COMMON TO SECTIONS 34-35, T41N-R29W
CEDAR POST BY AUSTIN BURT, D.S. 1846
HEMLOCK 14" N 41° E 30 LINKS
HEMLOCK 14" N 48° W 22 LINKS

B. Description of corner evidence found and/or method applied in restoring or reestablishing corner:

H-13 FOUND 1" PIPE WITH 4" MICHIGAN DEPARTMENT
OF CONSERVATION BRASS CAP, SET BY DEAN
DE LA MATER R.L.S. # 13030 FOUND 2 EXISTING
CEDAR B.T.'S IN POOR CONDITION.
1954 BEARING TREES
14" CEDAR S 48° W 25 LINKS
12" CEDAR S 40° E 29 LINKS

I-13 FOUND 1" PIPE WITH 4" MICHIGAN DEPARTMENT OF
CONSERVATION BRASS CAP, SET BY DEAN DE LA MATER
R.L.S. # 13030.
NO WITNESSES SET IN 1954.


C. Description of monument for corner and accessories established to perpetuate locating the position of the corner:

H-13 FOUND ABOVE DESCRIBED MONUMENT IN PLACE.
NEW WITNESSES.
8" WHITE BIRCH NORTH (M.B.) 32.60' NAIL/TAG
5" HARD MAPLE S 73° E (M.B.) 49.55' NAIL/TAG
12" CEDAR S 19° E (M.B.) 45.49' NAIL/TAG
12" BLACK SPRUCE S 75° W (M.B.) 25.63' NAIL/TAG
CARSONITE MARKER WEST 0.90'

I-13 FOUND ABOVE DESCRIBED MONUMENT IN PLACE
NEW WITNESSES.
8" SPRUCE N 08° E (M.B.) 22.60' NAIL/TAG
3" BALSAM S 13° E (M.B.) 12.50' NAIL/TAG
6" BALSAM S 30° E (M.B.) 12.40' NAIL/TAG
2" CHERRY S 55° W (M.B.) 8.15' NAIL/TAG
CARSONITE MARKER S 65° E 1.15'

Signed by JAMES H. MOORE
Surveyor's Michigan License No. 28423

Date 11-8-99

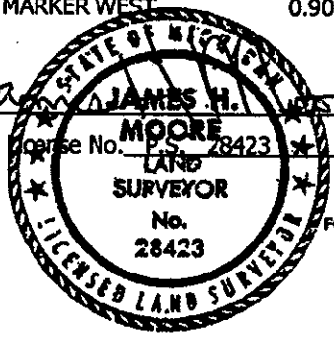

FORM APPROVED BY MICHIGAN STATE BOARD OF PROFESSIONAL SURVEYORS, JAN. 28, 1971

ADOPTED BY THE DICKINSON COUNTY
COUNCIL PEER GROUP AS THE OFFICIAL
CORNER UNDER MICHIGAN PUBLIC ACT
345 OF 1990 AT A MEETING HELD ON
11-23-99
COUNTY REPRESENTATIVE

REVISED MAY 14, 1975
REVISED JAN., 1983
REVISED OCT., 1995