

SURVEY & REMONUMENTATION

MAR 03 1998

LAND CORNER RECORDATION CERTIFICATE
 Filing Requirement of Act 74, Mich. P.A. 1970

RECORDED
 1997 DEC 10 PM 3:55

SECTION

For corners in

Dickinson
 (County)

Located In:

Corner Code #

Breitung Twp.

- | | | | | | |
|--------------------------------------|---|-----|---|-----|-----|
| 1. Public Land Survey | T | 40N | R | 31W | L-7 |
| | T | | R | | |
| | T | | R | | |
| | T | | R | | |
| 2. Property Controlling in Section | S | | T | | R |
| | S | | T | | R |
| 3. Miscellaneous Property in Section | S | | T | | R |
| | S | | T | | R |

REGISTER OF DEEDS
 DICKINSON COUNTY
 RON MOORE, CLERK

Register of Deeds Stamp & File Number

4. Lot No. _____, Recorded Plat _____
 5. Private Claims _____

I, Robert F. Perkins, in a field survey on Oct. 3, 19 97, do hereby certify that under requirements of P.A. 74, Michigan P.A. of 1970, the corner points mentioned in lines 1 and 2 above were in conformance with regulations and rules therefore as required in the current manual of survey instructions of the United States Department of the Interior, Bureau of Land Management or by a decree of a Court of Law and/or that the corner points mentioned in lines 3, 4 and 5 above were in conformance with the rules of the Michigan Board of Professional Surveyors or by a Decree of a Court of Law; established, re-established, monumented, re-monumented, recovered, found as expressed below:

A	B	C	D	E	F	G	H	I	J	K	L	M
2	6	5	4	3	2	1						
3												
4	7	8	9	10	11	12						
5												
6	18	17	16	15	14	13						
7												
8	19	20	21	22	23	24						
9												
10	30	29	28	27	26	25						
11												
12	31	32	33	34	35	36						
13												

NOTE: Not more than 4 corners, all in the same town and range, may be recorded on this certificate.

A. Description of original monument and accessories and/or subsequent restoration:

L-7 ¼ Corner Common to Sections 13 and 24
 Post by James H. Mullett, D.S. 1849
 Original Bearing Trees
 Pine Stub 20" N19°W 60 Lks.
 Pine Stub 24" S44°W 19 Lks.

ACCEPTED BY THE DICKINSON COUNTY SURVEY PEER GROUP AS THE OFFICIAL CORNER UNDER MICHIGAN PUBLIC ACT 345 OF 1990 AT A MEETING HELD ON

12-9-97


COUNTY REPRESENTATIVE

B. Description of corner evidence found and/or method applied in restoring or reestablishing corner:

L-7 No Evidence of Original Corner or Accessories Remains.
 Found 4½" Concrete Monument with D.N.R. Brass Cap Set by G.A. Shadko, RLS in 1960. Corner is ± 1' South of existing East-West Fence.

C. Description of monument for corner and accessories established to perpetuate locating the position of the corner:

L-7 Accepted above described Monument as Corner
 New Witnesses:
 J. Pine 8" S20°E (M.B.) 27.30' Nail/Tag
 J. Pine 6" S33°W (M.B.) 13.80' Nail/Tag
 J. Pine 8" N67°W (M.B.) 11.40' Nail/Tag
 J. Pine 4" N 7°W (M.B.) 19.27' Nail/Tag
 Carsonite Marker North 0.4'

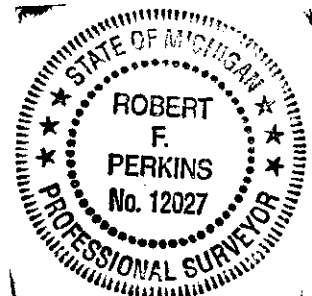

Signed by Robert F. Perkins

Date Nov. 25, 1997

Surveyor's Michigan License No. 12027

FORM APPROVED BY MICHIGAN STATE BOARD OF PROFESSIONAL SURVEYORS, JAN. 26, 1971
 REVISED MAY 14, 1975
 REVISED JAN., 1983