

LAND CORNER RECORDATION CERTIFICATE  
Filing Requirement of Act 74, Mich. P.A. 1970

For corners in

DICKINSON

(County)

NORWAY TOWNSHIP

Located In:

Corner Code #

1. Public Land Survey

T 41 N R 29 W

F-11

T 41 N R 29 W

G-11

T R

T R

2. Property Controlling  
in Section

S

T R

S

T R

3. Miscellaneous

S

T R

Property in Sec.

S

T R

SURVEY &

REMONUMENTATION

MAR 24 2000

RECORDED

1999 NOV 30 PM 3:31

REGISTER OF DEEDS  
DICKINSON COUNTY  
RON MOORE 11-23-99

Register of Deeds Stamp & File  
Number

4. Lot No. , Recorded Plat SECTION

5. Private Claims

I, JAMES H. MOORE, in a field survey on SEPTEMBER 2, 19 99 do hereby state that under requirements of P.A. 74, Michigan P.A. of 1970, the corner points mentioned in lines 1 and 2 above were in conformance with regulations and rules therefore as required in the current manual of survey instructions of the United States Department of the Interior, Bureau of Land Management or by a decree of a Court of Law and/or that the corner points mentioned in lines 3, 4 and 5 above were in conformance with the rules of the Michigan Board of Land Surveyors or by a Decree of a Court of Law; established, re-established, monumented, recovered, found as expressed below:

NOTE: Not more than 2 corners, all in the same town and range, may be recorded on this certificate.

	A	B	C	D	E	F	G	H	I	J	K	L	M
1													
2	6		5		4		3		2		1		
3													
4	7		8		9		10		11		12		
5													
6	18		17		16		15		14		13		
7													
8	19		20		21		22		23		24		
9													
10	30		29		28		27		26		25		
11													
12	31		32		33		34		35		36		
13													

A. Description of original monument and accessories and/or subsequent restoration:

F-11 1/4 CORNER COMMON TO SECTIONS 28-33  
BLACK ASH POST BY JOHN BURT, D.S. 1849  
BLACK ASH 14" N 52° E 15 LINKS  
YELLOW BIRCH 9" S 61° W 50 LINKS

G-11 CORNER COMMON TO SECTIONS 27-28-33-34  
CEDAR POST BY JOHN BURT, D.S. 1849  
YELLOW PINE 12" N 25° W 27 LINKS  
YELLOW PINE 12" S 67° E 10 LINKS

B. Description of corner evidence found and/or method applied in restoring or reestablishing corner:

F-11 FOUND 1" PIPE WITH 4" MICHIGAN DEPARTMENT  
OF CONSERVATION BRASS CAP, SET BY BILL  
BUCKLER R.L.S. #08887.

G-11 FOUND 1" PIPE WITH 4" MICHIGAN DEPARTMENT OF  
NATURAL RESOURCES ALUMINUM CAP, SET BY BILL  
BUCKLER R.L.S. #08887.

1955 BEARING TREES

CEDAR 8" N 37° E 19 LINKS  
WHITE SPRUCE 9" S 15° W 18 LINKS

1955 BEARING TREES

RED PINE 14" S 57° E 17 LINKS  
WHITE PINE 14" N 47° W 21 LINKS

C. Description of monument for corner and accessories established to perpetuate locating the position of the corner:

E-11 NEW WITNESSES FOUND ABOVE DESCRIBED MONUMENT  
IN PLACE.  
NEW WITNESSES


G-11 FOUND ABOVE DESCRIBED MONUMENT IN PLACE.  
NEW WITNESSES

9" CEDAR N 47° W (M.B.) 10.61' NAIL/TAG  
9" CEDAR N 13° E (M.B.) 17.48' NAIL/TAG  
FOUND 12" CEDAR N 40° E (M.B.) 12.80' NAIL/TAG  
FOUND 12" WHITE SPRUCE S 23° W (M.B.) 12.20' NAIL/TAG  
CARSONITE MARKER NORTH 1.20'

9" RED PINE N 17° E (M.B.) 7.75' NAIL/TAG  
11" RED PINE N 60° E (M.B.) 7.32' NAIL/TAG  
FOUND 14" RED PINE S 52° E (M.B.) 11.60' NAIL/TAG  
11" RED PINE S 61° W (M.B.) 22.02' NAIL/TAG  
CARSONITE MARKER S 25° E 3.55'

Signed by JAMES H. MOORE  
Surveyor's Michigan License 28423

Date 11-8-99

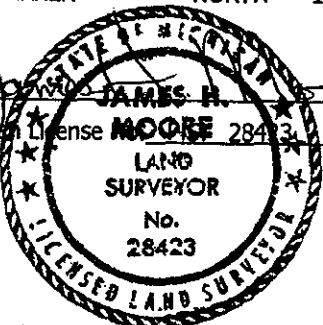

ACCEPTED BY THE DICKINSON COUNTY  
SURVEY FILER GROUP AS THE OFFICIAL  
CORNER UNDER MICHIGAN PUBLIC ACT  
345 OF 1980 AT A MEETING HELD ON

11-23-99

Robert J. Anderson  
COUNTY REPRESENTATIVE

REVISED MAY 14, 1975  
REVISED JAN., 1983  
REVISED OCT., 1995

LIBER 3 PAGE 6