

LAND CORNER RECORDATION CERTIFICATE  
Filing Requirement of Act 74, Mich. P.A. 1970

RECORDED

1999 NOV 30 PM 3:23

For corners in

DICKINSON  
(County)  
BREITUNG TOWNSHIP

Located In:

Corner Code #

1. Public Land Survey

T 41 N R 30 W

D-9

T 41 N R 30 W

E-9

T R

T R

2. Property Controlling  
in Section

S

T R

S

T R

3. Miscellaneous  
Property in Sec.

S

T R

S

T R

SURVEY &

REMONUMENTATION

Register of Deeds Stamp & File  
Number

4. Lot No. , Recorded Plat MAR 24 2000

5. Private Claims SECTION

I, JAMES H. MOORE, in a field survey on AUGUST 18, 19 99 do hereby state that under requirements of P.A. 74, Michigan P.A. of 1970, the corner points mentioned in lines 1 and 2 above were in conformance with regulations and rules therefore as required in the current manual of survey instructions of the United States Department of the Interior, Bureau of Land Management or by a decree of a Court of Law and /or that the corner points mentioned in lines 3, 4 and 5 above were in conformance with the rules of the Michigan Board of Land Surveyors or by a Decree of a Court of Law; established, re-established, monumented, recovered, found as expressed below:

NOTE: Not more than 2 corners, all in the same town and range, may be recorded on this certificate.

	A	B	C	D	E	F	G	H	I	J	K	L	M
1													
2	6			5		4		3		2		1	
3													
4	7			8		9		10		11		12	
5													
6	18			17		16		15		14		13	
7													
8	19			20		21		22		23		24	
9													
10	30			29		28		27		26		25	
11													
12	31			32		33		34		35		36	
13													

A. Description of original monument and accessories and/or subsequent restoration:

D-9 ¼ CORNER COMMON TO SECTIONS 20 - 29  
CEDAR POST BY JOHN BURT, D.S. 1849  
WHITE BIRCH 6" S 51° W 5 LINKS  
TAMARACK 5" NORTH 14 LINKS

E-9 CORNER COMMON TO SECTIONS 20 - 21 - 28 - 29  
SUGAR POST BY JOHN BURT, D.S. 1849  
WHITE PINE 22" N 78° E 36 LINKS  
ASPEN 9" S 78° W 20 LINKS

B. Description of corner evidence found and/or method applied in restoring or reestablishing corner:

D-9 FOUND 1 ½" PIPE. PER ROBERT SPEAR  
REMONUMENTATION REPORT  
DATED 12-7-98.

E-9 FOUND 1 ½" PIPE. FOUND EXISTING B.T. PER  
ROBERT SPEAR REMONUMENTATION REPORT  
DATED 12-7-98.

C. Description of monument for corner and accessories established to perpetuate locating the position of the corner:

D-9 SET DICKINSON COUNTY MONUMENT WITH 4"  
ALUMINUM CAP. NEW WITNESSES.

E-9 SET DICKINSON COUNTY MONUMENT WITH 4" ALUMINUM  
CAP. NEW WITNESSES.


EXISTING B.T. 6" CEDAR S 58° E (M.B.) 24.12' NAIL/TAG  
7" CEDAR N 68° E (M.B.) 24.92' NAIL/TAG  
9" CEDAR N 36° W (M.B.) 22.75' NAIL/TAG  
9" CEDAR S 75° W (M.B.) 22.44' NAIL/TAG  
CARSONITE MARKER NORTH (M.B.) 0.40'

EXISTING 15" OAK N 77° E (M.B.) 11.00' NAIL/TAG  
4" BALSAM N 24° W (M.B.) 21.10' NAIL/TAG  
4" MAPLE N 87° W (M.B.) 22.90' NAIL/TAG  
5" MAPLE S 41° E (M.B.) 46.56' NAIL/TAG  
CARSONITE MARKER NORTH (M.B.) 1.00'

Signed by

Date 11-8-99

Surveyor's Michigan License

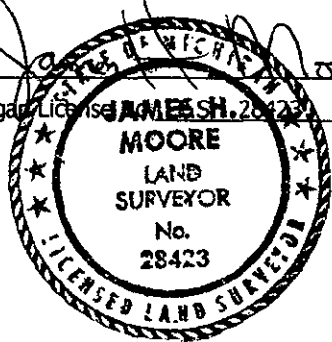

FORM APPROVED BY MICHIGAN STATE BOARD OF PROFESSIONAL SURVEYORS, JAN. 28, 1971

REVISED MAY 14, 1975

REVISED JAN., 1983

REVISED OCT., 1995

ACCEPTED BY THE DICKINSON COUNTY  
SURVEY PEER GROUP AS THE OFFICIAL  
CORNER UNDER MICHIGAN PUBLIC ACT  
345 OF 1990 AT A MEETING HELD ON

COUNTY REPRESENTATIVE

Liber 3 PAGE 14

11-23-99