

LAND CORNER RECORDATION CERTIFICATE  
Filing Requirement of Act 74, Mich. P.A. 1970 as Amended

For corners in

Dickinson	Located In:	Corner Code #
(County)		
Felch Township		
1. Public Land Survey	T _____ R _____	_____
	T _____ R _____	_____
	T _____ R _____	_____
2. Property Controlling in Section	S 14 T 42N R 29W	7
	S 14 T 42N R 29W	9
	S _____ T _____ R _____	_____
3. Miscellaneous Property in Sec.	S _____ T _____ R _____	_____
	S _____ T _____ R _____	_____
4. Lot No. _____, Recorded Plat _____		
5. Private Claims		

Register of Deeds Stamp & File Number

	A	B	C	D	E	F	G	H	I	J	K	L	M
1													
2	6		5		4		3		2		1		
3													
4	7		8		9		10		11		12		
5													
6	18		17		16		15		14		13		
7													
8	19		20		21		22		23		24		
9													
10	30		29		28		27		26		25		
11													
12	31		32		33		34		35		36		
13													

I, Jeremy J. Pipp, in a field survey on 8/06/2012AD do hereby state that under requirements of P.A. 74, Michigan P.A. of 1970, the corner points mentioned in lines 1 and 2 above were in conformance with regulations and rules therefore as required in the current manual of survey instructions of the United States Department of the Interior, Bureau of Land Management or by a decree of a Court of Law and /or that the corner points mentioned in lines 3, 4 and 5 above were in conformance with the rules of the Michigan Board of Land Surveyors or by a Decree of a Court of Law; established, re-established, monumented, recovered, found as expressed below:

NOTE: Not more than 2 corners, all in the same town and range, may be recorded on this certificate.

A. Description of original monument and accessories and/or subsequent restoration:

(07) North One-Sixteenth corner common to Sections 13 and 14. Not set in original survey, no evidence of subsequent establishment.

(09) Center-East One-Sixteenth corner of Section 14. Not set in original survey, no evidence of subsequent establishment.

B. Description of corner evidence found and/or method applied in restoring or reestablishing corner:

(07) Corner position established mid-point and on-line between the East One-Quarter corner and the Northeast corner of Section 14.

(09) Corner position established mid-point and on-line between the Center One-Quarter corner and the East One-Quarter corner of Section 14.

C. Description of monument for corner and accessories established to perpetuate locating the position of the corner:

(07) DNR monument  
18" Spruce S85E 16.41' (1/16S,BT)  
12" Balsam S03E 32.44' (1/16S,BT)  
13" Balsam West 19.18' (1/16S,BT)  
10" Cherry N23W 23.26' (1/16S,BT)


All trees are blazed, scribed, and painted. Measurements are to nail in side of tree. Bearings are magnetic.

(09) DNR monument  
4" Ironwood N23E 28.05' (1/16S,BT)  
13" Maple S52E 22.75' (1/16S,BT)  
10" Maple S14W 34.14' (1/16S,BT)  
7" Maple N39W 26.72' (1/16S,BT)

All trees are blazed, scribed, and painted. Measurements are to nail in side of tree. Bearings are magnetic.

Signed by Jeremy J. Pipp Date August 29, 2012  
Surveyor's Michigan License No. 50447

For the Michigan Department of Natural Resources, PROFESSIONAL SURVEYOR

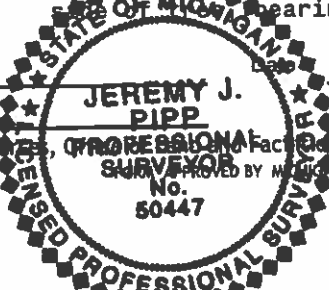

20113

20111

Revised May 14, 1975  
Revised Jan., 1983  
Revised Oct., 1995