

LAND CORNER RECORDATION CERTIFICATE
Filing Requirement of Act 74, Mich. P.A. 1970 as Amended

For corners in

Dickinson	Located In:	Corner Code #
(County)		
Felch Township		
1. Public Land Survey	T 42N R 29W	L03
	T 42N R 29W	K03
	T R	
2. Property Controlling in Section	S T R	
	S T R	
	S T R	
3. Miscellaneous Property in Sec.	S T R	
	S T R	
4. Lot No. , Recorded Plat		
5. Private Claims		

Register of Deeds Stamp & File Number

	A	B	C	D	E	F	G	H	I	J	K	L	M
1													
2	6		5		4		3		2		1		
3													
4	7		8		9		10		11		12		
5													
6	18		17		16		15		14		13		
7													
8	19		20		21		22		23		24		
9													
10	30		29		28		27		26		25		
11													
12	31		32		33		34		35		36		
13													

I, Jeremy J. Pipp, in a field survey on 8/01/2012AD do hereby state that under requirements of P.A. 74, Michigan P.A. of 1970, the corner points mentioned in lines 1 and 2 above were in conformance with regulations and rules therefore as required in the current manual of survey instructions of the United States Department of the Interior, Bureau of Land Management or by a decree of a Court of Law and /or that the corner points mentioned in lines 3, 4 and 5 above were in conformance with the rules of the Michigan Board of Land Surveyors or by a Decree of a Court of Law; established, re-established, monumented, recovered, found as expressed below:

NOTE: Not more than 2 corners, all in the same town and range, may be recorded on this certificate.

A. Description of original monument and accessories and/or subsequent restoration:

(L03) Quarter corner common to Sections 1 and 12. 1849: John Burt, DS. Set Ironwood post witnessed by Sugar 10 S60E 25 links (16.50'), Sugar 8 N25W 23 links (15.18').

(K03) Corner common to Sections 1, 2, 11, and 12. 1849: John Burt, DS. Set post witnessed by Sugar 9 S69E 30 links (19.80'), Sugar 8 N35W 28 links (18.48').

B. Description of corner evidence found and/or method applied in restoring or reestablishing corner:

(L03) No evidence of original survey or subsequent restoration found. Corner position reestablished by single proportionate measurement between the Southwest corner and the Southeast corner of Section 1. Position is accepted as a careful and faithful REESTABLISHMENT of the position of the original corner.

(K03) No evidence of original survey or subsequent restoration found. Corner position reestablished by double proportionate measurement between Section Corners One Mile North, One mile East, Two miles South, and One Mile West. Position is accepted as a careful and faithful REESTABLISHMENT of the position of the original corner.

C. Description of monument for corner and accessories established to perpetuate locating the position of the corner:


(L03) DNR monument
13" Maple N38E 9.63' (1/4S,NBT)
10" Maple S58E 11.33' (1/4S,NBT)
10" Maple S74W 6.82' (1/4S,NBT)
9" Maple N50W 14.94' (1/4S,NBT)
All trees are blazed, scribed, painted, and signed. Measurements are to nail in side of tree, bearings are magnetic. A carsonite rail was set North 1.5 feet.

Signed by Jeremy J. Pipp
Surveyor's Michigan License No. 50447

(K03) DNR monument
13" Maple N60E 26.03' (S1,NBT)
10" Maple S62E 31.62' (S12,NBT)
10" Maple S27W 25.25' (S11,NBT)
12" Maple N30W 18.60' (S2,NBT)
All trees are blazed, scribed, painted, and signed. Measurements are to nail in side of tree, bearings are magnetic. A carsonite rail was set North 1.5 feet.

August 28, 2012

For the Michigan Department of Natural Resources

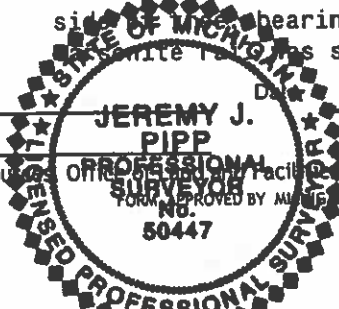

20103

20104

STATE BOARD OF PROFESSIONAL SURVEYORS, JAN. 28, 1971
Revised May 14, 1975
Revised Jan., 1983
Revised Oct., 1995