

LAND CORNER RECORDATION CERTIFICATE
Filing Requirement of Act 74, Mich. P.A. 1970 as Amended

For corners in

Dickinson	Located In:	Corner Code #
(County)		
1. Public Land Survey	T R	
	T R	
	T R	
2. Property Controlling in Section	S 15 T 43N R 27W	08
	S 15 T 43N R 27W	11
	S T R	
3. Miscellaneous Property in Sec.	S T R	
	S T R	
4. Lot No. , Recorded Plat		
5. Private Claims		

6/10/2013AD
6/10/2013AD
do hereby state
that under requirements of P.A. 74, Michigan P.A. of 1970, the corner points mentioned in lines 1 and 2 above were in conformance with regulations and rules therefore as required in the current manual of survey instructions of the United States Department of the Interior, Bureau of Land Management or by a decree of a Court of Law and /or that the corner points mentioned in lines 3, 4 and 5 above were in conformance with the rules of the Michigan Board of Land Surveyors or by a Decree of a Court of Law; established, re-established, monumented, recovered, found as expressed below:

NOTE: Not more than 2 corners, all in the same town and range, may be recorded on this certificate.

A. Description of original monument and accessories and/or subsequent restoration:

(08) Center-West One-Sixteenth corner of Section 15. Not set in original survey. Found Steve Applekamp (PS#43045) capped rebar.

(11) Southwest One-Sixteenth corner of Section 15. Not set in original survey, no evidence of subsequent establishment.

B. Description of corner evidence found and/or method applied in restoring or reestablishing corner:

(08) Accepted found Capped Rebar as marking Corner position mid-point and on-line between the Center One-Quarter corner and the West One-Quarter corner of Section 15.

(11) Corner position established at the intersection of the South and West One-Sixteenth lines of Section 15.


C. Description of monument for corner and accessories established to perpetuate locating the position of the corner:

(08) DNR monument
6" Cedar N58E 21.02' (1/16S,BT)
11" Cedar S56E 18.01' (1/16S,BT)
11" Tamarack S48W 10.00' (1/16S,BT)
8" Tamarack N50W 22.27' (1/16S,BT)
All trees are blazed, scribed, and painted. Measurements are to nail in side of tree, bearings are magnetic.

(11) DNR monument
4" Ironwood N51E 14.90' (1/16S,BT)
5" Ironwood S10E 24.91' (1/16S,BT)
8" Ironwood N47W 22.26' (1/16S,BT)
4" Maple N17W 35.12' (1/16S,BT)
All trees are blazed, scribed, and painted. Measurements are to nail in side of tree, bearings are magnetic.

Signed by
Surveyor's Michigan License No. 50447

For the Michigan Department of Natural Resources

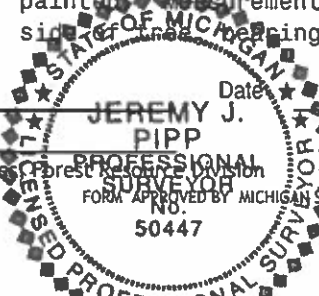

Date August 08, 2013