

MAR 28 1999

LAND CORNER RECORDATION CERTIFICATE
Filing Requirement of Act 74, Mich. P.A. 1970

For corners in

SECTION

Dickinson

Located in:

Corner Code #

RECORDED

1998 DEC 14 PM 4:30

FELCH TOWNSHIP

1. Public Land Survey

T 43 N R 28 W G-11

2. Property Controlling
in Section

S T R

3. Miscellaneous
Property in Sec.

S T R

4. Lot No. , Recorded Plat

5. Private Claims

REGISTER OF DEEDS
DICKINSON COUNTY
RON MOORE, CLERK

I, JAMES H. MOORE, in a field survey on JUNE 17, 1998 do hereby state that under requirements of P.A. 74, Michigan P.A. of 1970, the corner points mentioned in lines 1 and 2 above were in conformance with regulations and rules therefore as required in the current manual of survey instructions of the United States Department of the Interior, Bureau of Land Management or by a decree of a Court of Law and/or that the corner points mentioned in lines 3, 4 and 5 above were in conformance with the rules of the Michigan Board of Land Surveyors or by a Decree of a Court of Law; established, re-established, monumented, recovered, found as expressed below:

NOTE: Not more than 2 corners, all in the same town and range, may be recorded on this certificate

NOTE: SEE REVERSE SIDE FOR SECTION SUBDIVISION

	A	B	C	D	E	F	G	H	I	J	K	L	M
1													
2	6		5		4		3		2		1		
3													
4	7		8		9		10		11		12		
5													
6	18		17		16		15		14		13		
7													
8	19		20		21		22		23		24		
9													
10	30		29		28		27		26		25		
11													
12	31		32		33		34		35		36		
13													

A. Description of original monument and accessories and/or subsequent restoration:

ORIGINAL CORNER ESTABLISHED BY J. BURT - SEPT., 1850

ORIGINAL CORNER: WOOD POST

ORIGINAL BEARING TREES:

WHITE PINE 20" S 22° W 60 LINKS (39.60 feet)
MAPLE 12" N 20° E 32 LINKS (21.12 feet)

ACCEPTED BY THE DICKINSON COUNTY
SURVEY PEER GROUP AS THE OFFICIAL
CORNER UNDER MICHIGAN PUBLIC ACT
345 OF 1990 AT A MEETING HELD ON
12-7-98
RBP
COUNTY REPRESENTATIVE

B. Description of corner evidence found and/or method applied in restoring or reestablishing corner:

NO ORIGINAL EVIDENCE WAS FOUND.

CORNER WAS CONSIDERED TO BE LOST AND WAS THUS SET AND MONUMENTED AT A DOUBLE PROPORTIONATE LOCATION BETWEEN GOVT CORNERS (G-9 & G-12) AND (F-11 & I-11).


C. Description of monument for corner and accessories established to perpetuate locating the position of the corner:

AT A DOUBLE PROPORTION LOCATION I SET A 1" x 36" ALUMINUM ROD WITH A DICKINSON COUNTY ALUMINUM CAP, FROM WHICH I ESTABLISHED THE FOLLOWING NEW

BEARING TREES:

(all measurements taken to nail set in tree)

SW COR BLOCK FOUNDATION N 56° E 31.40 feet
MAPLE 14" S 34° E 35.43 feet
MAPLE 13" S 07° E 14.81 feet
TRI. MAPLE 8" N 55° W 65.55 feet
CARSONITE RAIL SOUTH 1.10 feet

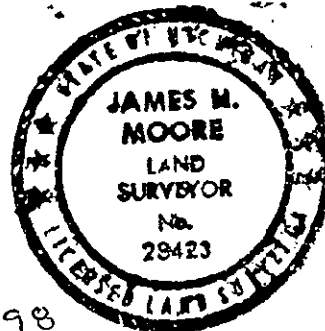

Signed by James H. Moore

Date 11-30-98

Surveyor's Michigan License No. P.S. 28423

