

LAND CORNER RECORDATION CERTIFICATE  
Filing Requirement of Act 74, Mich. P.A. 1970 as Amended

For corners in

Dickinson	Located In:	Corner Code #
(County)		
Felch Township		
1. Public Land Survey	T _____ R _____	_____
	T _____ R _____	_____
	T _____ R _____	_____
2. Property Controlling in Section	S 11 T 43N R 29W	4
	S 11 T 43N R 29W	5
	S _____ T _____ R _____	_____
3. Miscellaneous Property in Sec.	S _____ T _____ R _____	_____
	S _____ T _____ R _____	_____
4. Lot No. _____, Recorded Plat _____		
5. Private Claims _____		

Register of Deeds Stamp & File Number

	A	B	C	D	E	F	G	H	I	J	K	L	M
1													
2	6		5		4		3		2		1		
3													
4	7		8		9		10		11		12		
5													
6	18		17		16		15		14		13		
7													
8	19		20		21		22		23		24		
9													
10	30		29		28		27		26		25		
11													
12	31		32		33		34		35		36		
13													

I, Jeremy J. Pipp, in a field survey on 7/09/2012AD do hereby state  
that under requirements of P.A. 74, Michigan P.A. of 1970, the corner points mentioned in lines 1 and 2  
above were in conformance with regulations and rules therefore as required in the current manual of survey  
instructions of the United States Department of the Interior, Bureau of Land Management or by a decree of  
a Court of Law and /or that the corner points mentioned in lines 3, 4 and 5 above were in conformance with  
the rules of the Michigan Board of Land Surveyors or by a Decree of a Court of Law; established,  
re-established, monumented, recovered, found as expressed below:

NOTE: Not more than 2 corners, all in the same town and range, may be recorded  
on this certificate.

A. Description of original monument and accessories and/or subsequent restoration:

(04) Northwest One-Sixteenth corner of Section 11. Not set in original survey, no  
evidence of subsequent establishment.

(05) Center-North One-Sixteenth corner of Section 11. Not set in original survey, no  
evidence of subsequent establishment.

B. Description of corner evidence found and/or method applied in restoring or reestablishing corner:

(04) Corner position established at the intersection of the North and West One-Sixteenth  
lines of Section 11.

(05) Corner position established mid-point and on-line between the Center One-Quarter  
corner and the North One-Quarter corner of Section 11. Monument located 6" below grade,  
and in North rut of access drive in camp yard.


C. Description of monument for corner and accessories established to perpetuate locating the position of the corner:

(04) DNR monument  
7" Aspen N10E 17.49' (1/16S,BT)  
6" Cherry S52E 29.96' (1/16S,BT)  
17" Spruce S29W 33.48' (1/16S,BT)  
21" Spruce N65W 60.42' (1/16S,BT)  
All trees are blazed, scribed, and  
painted. Measurements are to nail in  
side of tree, bearings are magnetic.

(05) DNR monument  
14" Spruce N43E 33.34' (1/16S,BT)  
8" Spruce N68E 22.90' (1/16S,BT)  
5" Tamarack S10W 16.47' (1/16S,BT)  
8" Tamarack S56W 26.65' (1/16S,BT)  
SE Building Cor. Foundation N62W 41.5'  
All trees are blazed, scribed, and  
painted. Measurements are to nail in  
side of tree, bearings are magnetic.

Signed by Jeremy J. Pipp  
Surveyor's Michigan License No. 50447

For the Michigan Department of Natural Resources,

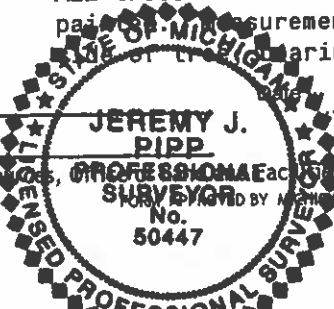

July 18, 2012

20088

20090

Revised May 14, 1975  
Revised Jan., 1983  
Revised Oct., 1995