

LAND CORNER RECORDATION CERTIFICATE
Filing Requirement of Act 74, Mich. P.A. 1970 as Amended

For corners in

Dickinson (County)
Located In:
Corner Code #
1. Public Land Survey
2. Property Controlling in Section
3. Miscellaneous Property in Sec.
4. Lot No.
5. Private Claims

Register of Deeds Stamp & File Number

Table with 13 rows and 13 columns (A-M) for Register of Deeds Stamp & File Number.

I, Jeremy J. Pipp, in a field survey on 7/09/2012AD do hereby state that under requirements of P.A. 74, Michigan P.A. of 1970, the corner points mentioned in lines 1 and 2 above were in conformance with regulations and rules therefore as required in the current manual of survey instructions of the United States Department of the Interior, Bureau of Land Management or by a decree of a Court of Law and /or that the corner points mentioned in lines 3, 4 and 5 above were in conformance with the rules of the Michigan Board of Land Surveyors or by a Decree of a Court of Law; established, re-established, monumented, recovered, found as expressed below:

NOTE: Not more than 2 corners, all in the same town and range, may be recorded on this certificate.

A. Description of original monument and accessories and/or subsequent restoration:

(K02) Quarter Corner common to Sections 1 and 2. 1848: Harvey Mellen, DS. Set Cedar post witnessed by: Fir 8 S59W 20 links (13.20'); Cedar 12 N47E 37 links (24.42').

(K03) Corner common to Sections 1, 2, 11, and 12. 1848: Harvey Mellen, DS. Set Cedar post witnessed by: Cedar 12 S23W 37 links (24.42'); Cedar 9 N64E 10 links (6.60').

B. Description of corner evidence found and/or method applied in restoring or reestablishing corner:

(K02) No evidence of original survey or subsequent restoration found. Corner position reestablished by single proportionate measurement between the Southeast corner and the Northeast corner of Section 2. Position checks within reason to adjacent 'leave swamp' & 'enter swamp' calls North & South. Position is accepted as a careful and faithful REESTABLISHMENT of the position of the original corner.

(K03) No evidence of original survey or subsequent restoration found. Corner position reestablished by double proportionate measurement using Section & One-Quarter Corner(s) of record one mile North, one mile East, 1/2 mile South, and 1/2 mile West. Position check within reason to 'leave swamp' calls North & East. Position is accepted as a careful and faithful REESTABLISHMENT of the position of the original corner.

C. Description of monument for corner and accessories established to perpetuate locating the position of the corner:


(K02) DNR monument
7" Aspen N59E 27.06' (1/4S,NBT)
6" Aspen S56E 6.30' (1/4S,NBT)
7" Aspen S01W 3.52' (1/4S,NBT)
6" Aspen N61W 2.95' (1/4S,NBT)

(K03) DNR monument
11" Spruce N35E 65.15' (S1,NBT)
4" Spruce N89E 31.42' (S1,NBT)
10" Maple S51E 51.65' (S12,NBT)
5" White Birch S65W 8.72' (S11,NBT)

All trees are blazed, scribed, painted, and signed. Measurements are to nail in side of tree, bearings are magnetic. A carsonite rail was set North 1.5 feet.

All trees are blazed, scribed, painted, and signed. Measurements are to nail in side of tree, bearings are magnetic. A carsonite rail was set North 1.5 feet.

Signed by [Signature]
Surveyor's Michigan License No. 50447

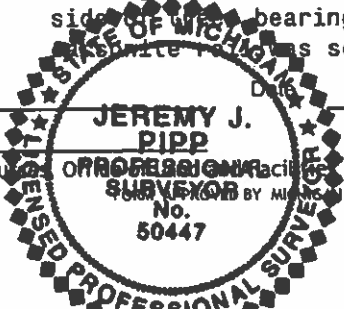

For the Michigan Department of Natural Resources

July 18, 2012

20087

20085