

LAND CORNER RECORDATION CERTIFICATE
Filing Requirement of Act 74, Mich. P.A. 1970 as Amended

For corners in

Dickinson	Located In:	Corner Code #
(County)		
FELCH TOWNSHIP		
1. Public Land Survey	T 43N R 29W	E10
	T 43N R 29W	F09
	T R	
2. Property Controlling in Section	S T R	
	S T R	
	S T R	
3. Miscellaneous Property in Sec.	S T R	
	S T R	

4. Lot No. _____, Recorded Plat _____
5. Private Claims _____

2/26/2013AD
2/27/2013AD
do hereby state
that under requirements of P.A. 74, Michigan P.A. of 1970, the corner points mentioned in lines 1 and 2 above were in conformance with regulations and rules therefore as required in the current manual of survey instructions of the United States Department of the Interior, Bureau of Land Management or by a decree of a Court of Law and /or that the corner points mentioned in lines 3, 4 and 5 above were in conformance with the rules of the Michigan Board of Land Surveyors or by a Decree of a Court of Law; established, re-established, monumented, recovered, found as expressed below:

NOTE: Not more than 2 corners, all in the same town and range, may be recorded on this certificate.

A. Description of original monument and accessories and/or subsequent restoration:

(E10) Quarter corner common to Sections 28 and 29. 1848: Harvey Mellen, DS. Set B. Ash post witnessed by: Cedar 14 S64W 7 links (4.62'); Cedar 8 N25E 13 links (8.58'); 1992: Michigan DNR (Keith Sackett PS#19006) Found 1 1/2" ID Pipe added witnesses 6" Cedar N50W 45.5', 5" Cedar N69E 37.4', 8" ASH S42W 36.9', 4" Ash S31E 24.5, 8" Ash squared N59E 1.0'.

(F09) Quarter corner common to Sections 21 and 28. 1848: Harvey Mellen, DS. Set Cedar post witnessed by: Cedar 6 N78W 6 links (3.96'); Yellow Birch 6 S36E 12 links (7.92'); 1980: Michigan DNR (Arthur Enger PS#13581) Set 1" Pipe with 3 3/4"aluminum cap witnessed by B. Spruce 8 S52W 22.8', B. Spruce 6 N76E 2.5', W. Birch 6 N07W 4.1'.

B. Description of corner evidence found and/or method applied in restoring or reestablishing corner:

(E10) Accepted 1 1/2" ID pipe and set a MDNR Monument inside of existing pipe as a careful and faithful REESTABLISHMENT of the position of the original corner.

(F09) Accepted found MDNR Monument as a careful and faithful REESTABLISHMENT of the position of the original corner.

C. Description of monument for corner and accessories established to perpetuate locating the position of the corner:

(E10) DNR monument
EX 8" Cedar N70E 37.17' (1/4S,NBT)
EX 6" ASH S31E 24.58' (1/4S,NBT)
4" ASH S06W 26.49' (1/4S,NBT)
EX. 9" Cedar N50W 45.74' (1/4S,NBT)

All trees are blazed, scribed, and painted. Measurements are to nail in side of tree, bearings are magnetic. A Carsonite rail was set North 1.5 feet.

Signed by _____
Surveyor's Michigan License No. 50447

(F09) DNR monument
6" B. Spruce N44E 25.48' (1/4S,NBT)
8" B. Spruce S21E 7.19' (1/4S,NBT)
4" Tamarack S86W 15.38' (1/4S,NBT)
5" Tamarack N02W 21.79' (1/4S,NBT)


All trees are blazed, scribed, and painted. Measurements are to nail in side of tree, bearings are magnetic. A Carsonite rail was set North 1.5 feet.

Date: July 22, 2013

For the Michigan Department of Natural Resources, Forest Survey Division

20188

20191

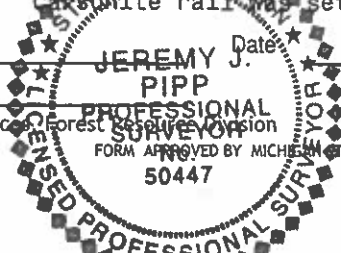

Register of Deeds Stamp & File Number												
A	B	C	D	E	F	G	H	I	J	K	L	M
1												
2	6		5		4		3		2		1	
3												
4	7		8		9		10		11		12	
5												
6	18		17		16		15		14		13	
7												
8	19		20		21		22		23		24	
9												
10	30		29		28		27		26		25	
11												
12	31		32		33		34		35		36	
13												

FORM APPROVED BY MICHIGAN STATE BOARD OF PROFESSIONAL SURVEYORS, JAN. 28, 1971
Revised May 14, 1975
Revised Jan., 1983
Revised Oct., 1995