

LAND CORNER RECORDATION CERTIFICATE
Filing Requirement of Act 74, Mich. P.A. 1970

For corners in

Dickinson

(County)

Located In:

Corner Code #

1. Public Land Survey

T 44N	R 27W	J1
T 44N	R 27W	MC S of I1
T	R	
T	R	
S	T	
S	T	
S	T	
S	T	

2. Property Controlling
in Section

3. Miscellaneous
Property in Sec.

4. Lot No. _____, Recorded Plat _____

5. Private Claims _____

MC Oct 10 2001

J1 Oct 16 2001

I, Paul R. Bressette, in a field survey on _____, 20____ do hereby state that under requirements of P.A. 74, Michigan P.A. of 1970, the corner points mentioned in lines 1 and 2 above were in conformance with regulations and rules therefore as required in the current manual of survey instructions of the United States Department of the Interior, Bureau of Land Management or by a decree of a Court of Law and /or that the corner points mentioned in lines 3, 4 and 5 above were in conformance with the rules of the Michigan Board of Land Surveyors or by a Decree of a Court of Law; established, re-established, monumented, recovered, found as expressed below:

NOTE: Not more than 2 corners, all in the same town and range, may be recorded on this certificate.

Register of Deeds Stamp & File Number

	A	B	C	D	E	F	G	H	I	J	K	L	M
1													
2	6		5		4		3		2		1		
3													
4	7		8		9		10		11		12		
5													
6	18		17		16		15		14		13		
7													
8	19		20		21		22		23		24		
9													
10	30		29		28		27		26		25		
11													
12	31		32		33		34		35		36		
13													

A. Description of original monument and accessories and/or subsequent restoration:

(J1) Quarter corner common to Sections 2 and 35. 1846: Austin Burt, DS. Set wood post witnessed by: Aspen 7 N50E 6 lks.; Aspen 10 N73W 27 lks.

(MC S of I1) Meander corner between Sections 2 and 3 on west side of Kate Lake. 1850: John Burt, D.S. White Pine 15 for Meander corner witnessed by: Spruce 10 S61W 41 lks. 1952: Dean Delamater, RLS. Found squared 15" White Pine scribed for corner down, but in excellent condition. Set 1" iron pipe with 4" brass cap witnessed by: 10" Cedar N50W 15 lks.; 6" Cedar S30E 48 lks.


B. Description of corner evidence found and/or method applied in restoring or reestablishing corner:

(J1) No evidence of original survey or subsequent restoration found. Corner position reestablished by single proportion between the meander corner on the west shore of Kates Lake and the northeast corner of Section 1, and is accepted as a careful and faithful REESTABLISHMENT of the position of the original corner.

(MC S of I1) Found monument and witnesses as described. Monument was found leaning, about 6" in ground. Witnesses both live and standing with both faces closed. Pine corner tree still evident, in fair condition lying to east extending into lake. Bearings and distances to witnesses did not check to monument. Monument was reset from the witnesses, and is accepted as a careful and faithful PERPETUATION of the position of the original corner.

C. Description of monument for corner and accessories established to perpetuate locating the position of the corner:

(J1) DNR monument	(MC S of I1) 1" pipe w/4" brass cap
09" R.Maple N69E 24.15' (1/4S,NBT)	07" R.Maple East 12.5' (MC,NBT)
05" Spruce S45E 34.9' (1/4S,NBT)	09" Cedar S27E 32.6' (EX.NBT)
07" R.Maple S48W 32.3' (1/4S,NBT)	06" B.Ash S49W 27.0' (MC,NBT)
15" W.Pine N82W 40.95' (1/4S,NBT)	14" Cedar N40W 10.3' (EX.NBT)
All trees are blazed, scribed and painted. Measurements are to nail in side of tree, bearings are magnetic.	All trees are blazed, scribed and painted. Measurements are to nail in side of tree, bearings are magnetic.

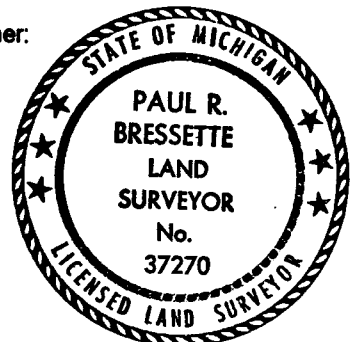

Signed by Paul R. Bressette

Date _____

Surveyor's Michigan License No. 37270

For the Michigan Department of Natural Resources - Forest Management Division