

MICHIGAN  
DEPARTMENT OF CONSERVATION  
FORESTRY DIVISION

LAND CORNER RECORD

~~44~~ 29 W  
T. 45. NR 29 W. . .

. . . Dickinson . . . . . COUNTY

DESCRIPTION OF CORNER . . . Section Corner common to Sections 4, 5, 32, 33 . .

DESCRIPTION OF CORNER MONUMENT . 1" pipe with 4" brass cap. . . . .

WITNESSES TO CORNER . . 18" White Pine . S 62° W . 192 links . . . . .

. . . . .  
. . . . .  
. . . . .

DESCRIPTION IN DETAIL AS TO HOW CORNER WAS LOCATED AND IDENTIFIED OR  
RESTORED.

Replaced Section Corner between 4 and 5 from original B.T.'s.

One Tamarack in excellent condition. One Yellow Pine in poor condition.


Section Corner is in approximate center of circular marsh.

Corner shown to us by H. S. Peterson, District Forester.

~~N. B. T. 's.~~

Corner placed and witnessed October 31, 1955

SURVEYORS SEAL

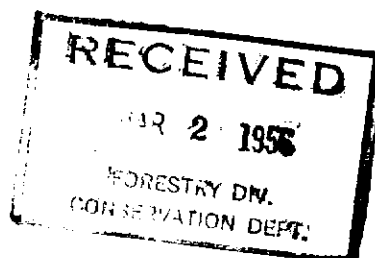

SIGNED

*Billy D. Buckles*  
REGISTERED LAND SURVEYOR

DATE 2/27/56