

SURVEY & REMONUMENTATION

JAN 22 1998

SECTION

LAND CORNER RECORDATION CERTIFICATE
Filing Requirement of Act 74, Mich. P.A. 1970

Register's Office } ss.
Gogebic County }

For corners in
Gogebic
(County)

Located In: Corner Code #
Section 13 44W 39W K-7
T R
T R
T R
T R
S T R
S T R
S T R
S T R

1. Public Land Survey
2. Property Controlling in Section
3. Miscellaneous Property in Sec.

Received for record the
24TH day of NOVEMBER
A. D. 1997 at 11:40 o'clock
A m., and recorded in
Liber 6 of CORNERS
on page 259
Ramona Collins, Deputy
Register of Deeds

Register of Deeds Stamp & File Number

4. Lot No. , Recorded Plat
5. Private Claims
Section corner common to section 13, 14, 23 & 24 T44N, R39W

John R. Garske October 13, 97

I, in a field survey on 19 do hereby state that under requirements of P.A. 74, Michigan P.A. of 1970, the corner points mentioned in lines 1 and 2 above were in conformance with regulations and rules therefore as required in the current manual of survey instructions of the United States Department of the Interior, Bureau of Land Management or by a decree of a Court of Law and/or that the corner points mentioned in lines 3, 4 and 5 above were in conformance with the rules of the Michigan Board of Land Surveyors or by a Decree of a Court of Law; established, re-established, monumented, recovered, found as expressed below:

NOTE: Not more than 2 corners, all in the same town and range, may be recorded on this certificate.

	A	B	C	D	E	F	G	H	I	J	K	L	M
1													
2	6		5		4		3		2		1		
3													
4	7		8		9		10		11		12		
5													
6	18		17		16		15		14		13		
7													
8	19		20		21		22		23		24		
9													
10	30		29		28		27		26		25		
11													
12	31		32		33		34		35		36		
13													

A. Description of original monument and accessories and/or subsequent restoration:

Original corner set by Wells Burt, D.S. in 1851

Original B.T.'s :

Hemlock 24" N30°E 8 links

Cedar 10" S14°W 5 links

May 19, 1961 Donald Lappala, RLS 12585 found a concrete monument at the corner position which checked with original cedar B.T. he found. He established new bearing trees noted below and set a 2" I.D. brass capped pipe on the south side of the concrete monument. Corner recorded L1, pg. 30.

B. Description of corner evidence found and/or method applied in restoring or reestablishing corner:


I found the concrete monument and 3" brass cap on the galvanized pipe set by Lappala in 1961. Both were in good condition. I checked his bearing trees and set a steel sign rail as noted below.

(Research on file)

PEER GROUP APPROVED
Richard P. Dralun 11/11/97
COUNTY REPRESENTATIVE

C. Description of monument for corner and accessories established to perpetuate locating the position of the corner:

Found concrete monument and brass capped pipe from which:
12" hemlock S55°E 36.60 feet (existing)
14" cedar S23°W 37.25 feet (existing)
18" cedar N27°W 25.62 feet (existing)
12" cedar N70°E 42.25 feet (existing)
Steel sign rail Due west 1.40 feet
Measurements to nails in trees.

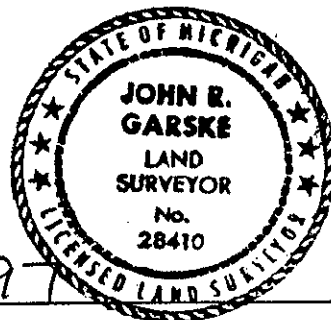

Signed by John R. Garske
Surveyor's Michigan License No. 28410

Date 11/11/97