

SURVEY & REMONUMENTATION

JAN 22 1998

SECTION

LAND CORNER RECORDATION CERTIFICATE  
Filing Requirement of Act 74, Mich. P.A. 1970

For corners in  
Gogebic  
(County)

Located In: Corner Code #

1. Public Land Survey

Section 13 44N 39W KL-7E  
T R # 005  
T R  
T R  
T R  
S T  
S T  
S T  
S T

2. Property Controlling  
in Section  
3. Miscellaneous  
Property in Sec.

4. Lot No. Recorded Plat  
5. Private Claims

M.C. on East Shore of Bay of Dinner Lake between sections 13 and 24

I, John R. Garske, in a field survey on October 13/97 do hereby state that under requirements of P.A. 74, Michigan P.A. of 1970, the corner points mentioned in lines 1 and 2 above were in conformance with regulations and rules therefore as required in the current manual of survey instructions of the United States Department of the Interior, Bureau of Land Management or by a decree of a Court of Law and for that the corner points mentioned in lines 3, 4 and 5 above were in conformance with the rules of the Michigan Board of Land Surveyors or by a Decree of a Court of Law; established, re-established, monumented, recovered, found as expressed below:

NOTE: Not more than 2 corners, all in the same town and range, may be recorded on this certificate.

Register's Office  
Gogebic County ss.

Received for record the  
24<sup>TH</sup> day of NOVEMBER  
A. D. 1997 at 11:40 o'clock  
A m., and recorded in  
Liber 6 of CORNER  
on page 264  
Ramona Collins, Deputy  
Register of Deeds

Register of Deeds Stamp & File Number

	A	B	C	D	E	F	G	H	I	J	K	L	M
1													
2	6			5		4		3		2		1	
3													
4	7			8		9		10		11		12	
5													
6	18			17		16		15		14		13	
7													
8	19			20		21		22		23		24	
9													
10	30			29		28		27		26		25	
11													
12	31			32		33		34		35		36	
13													

A. Description of original monument and accessories and/or subsequent restoration:

Original corner set by Wells Burt, in 1851 from which:

White Pine 24" N22° 7 links  
Yellow Pine 14" S75°E 15links


May 3, 1960 - Donald Lappala RLS for U.S.F.S. found evidence of original bearing trees  
May 27, 1987 - Gary Pisoni, RLS 27457 found the original GLO bearing trees as decayed stumps and monumented the M.C. which falls in the lake. He set a W.C. consisting of 2" x 30" alum. pipe monument with a 3" alum. cap stamped. He established bearing trees as noted below.. Corner recorded L3, pg. 251.

B. Description of corner evidence found and/or method applied in restoring or reestablishing corner.

I found the witness corner monument set by Pisoni in 1987 and his bearing trees all in good condition. I updated the corner as noted below.

(Research on file)


PEER GROUP APPROVED  
Richard L. DeBruin 11/10/97  
COUNTY REPRESENTATIVE

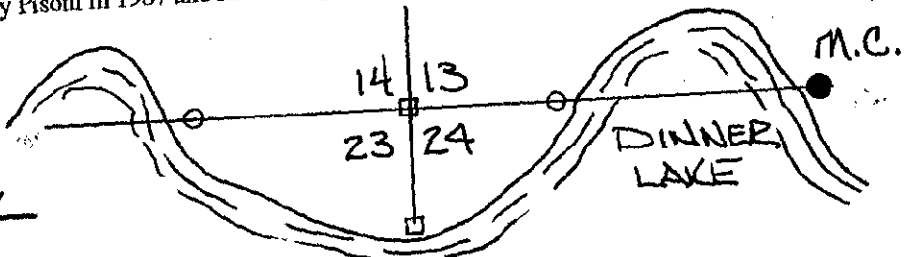

C. Description of monument for corner and accessories established to perpetuate locating the position of the corner:

I found 2" x 30" alum. pipe monument with a 3 1/4 alum. cap stamped to identify the corner, from which:

12" R. pine	N70°E	12.47 feet (12.36R) (existing)
10" R. pine	N04°W	23.92 feet (existing)
12" R. Pine	S32°E	18.26 feet (existing)
5/8" iron rod	S09°E	12.94 feet (13.00R) (existing)
Steel Sign Rail	East	1.3 feet (existing)

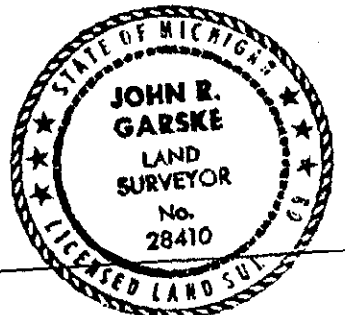

Signed by

John R. Garske  
28410

Surveyor's Michigan License No.

Date 11/11/97