

JAN 05 2001

SECTION

LAND CORNER RECORDATION CERTIFICATE

Filing Requirement of Act 74, Mich. P.A. 1970

For corners in

Gogebic
(County)

Located In:

Corner Code #

1. Public Land Survey

T44N R 39W

C-D-11

T R

T R

T R

2. Property Controlling
in Section

S T R

S T R

3. Miscellaneous

S T R

Property in Sec.

S T R

4. Lot No. , Recorded Plat

5. Private Claims

Meander Corner common to Sections 29 & 32 on West shore of Moon Lake.

I, John R. Garske, in a field survey on December 20, 19 99 do hereby state that under requirements of P.A. 74, Michigan P.A. of 1970, the corner points mentioned in lines 1 and 2 above were in conformance with regulations and rules therefore as required in the current manual of survey instructions of the United States Department of the Interior, Bureau of Land Management or by a decree of a Court of Law and /or that the corner points mentioned in lines 3, 4 and 5 above were in conformance with the rules of the Michigan Board of Land Surveyors or by a Decree of a Court of Law; established, re-established, monumented, recovered, found as expressed below:

NOTE: Not more than 2 corners, all in the same town and range, may be recorded on this certificate.

A. Description of original monument and accessories and/or subsequent restoration:

Corner established by Wells Burt, U.S. Deputy Surveyor, in 1851.

Original Bearing Trees: 14" Yellow Pine N 72° W 25 Links
4" White Birch S 60° W 35 Links

1961-Lappala, R.L.S. # 12585, set 2" x 5' concrete filled galvanized iron pipe capped with a 3" bronze cap witnessed by the following:

7" Red Maple	S 61°-30' W	6.8 Feet
10" Black Oak	S 75° W	40.6 Feet (slope)
5" White Birch	N 55° W	21.0 Feet (slope)
3" x 4" x 84" square cedar post	N 65°-30' W	10.9 Feet

Rec. August 29, 1962 in Liber #1, Pg. 12

B. Description of corner evidence found and/or method applied in restoring or reestablishing corner:

I found a 2" iron pipe capped with brass cap stamped "1961" bent slightly as noted above. I accepted the Lappala corner and established new accessories as noted below.

Record research on file.

PEER GROUP APPROVED
Richard L. Deahn 5/24/00
COUNTY SUPERVISOR

C. Description of monument for corner and accessories established to perpetuate locating the position of the corner:

I accepted the above described 2" iron pipe as the West meander corner of the South section line of Section 29. From this corner I established the following witnesses:

6 foot steel sign post	N 80° E	1.05 Feet
6 foot steel sign post	N 64° W	5.34 Feet
5" Red Maple	S 42° W	27.55 Feet
4" Oak	N 32° W	8.80 Feet

Signed by

John R. Garske

Surveyor's Michigan License No. 28410

U.S.F.S. Index # V-6-7.

Register's Office }
Gogebic County } ss.

Received for record the

2ND day of JUNEA. D. 19⁹⁹ at 10:20 o'clock



A m., and recorded in

Liber 7 of CORNERS

on page 348

Cheryl Rippe, Dep.
Register of Deeds

Register of Deeds Stamp & File
Number

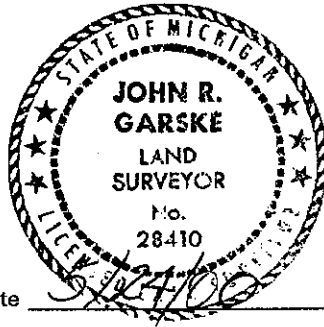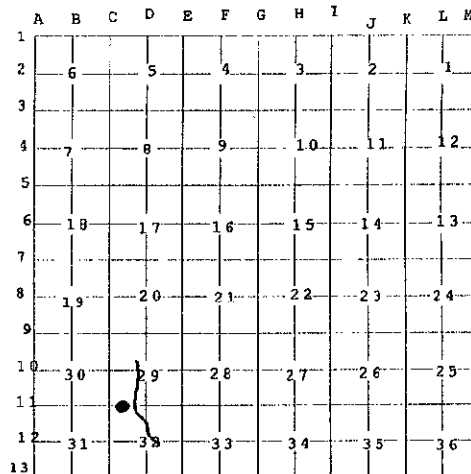

Date

5/24/00