

LAND CORNER RECORDATION CERTIFICATE
Filing Requirement of Act 74, Mich. P.A. 1970

Register's Office } ss.
Gogebic County }

Received for record the
18TH day of April
A. D. 1994 at 1:20 o'clock
P. m., and recorded in
Liber 5 of CORNARS
on page 28.

Register of Deeds

Register of Deeds Stamp & File Number

For corners in

Gogebic
(County)

Located In:

Corner Code ##

- | | | |
|------------------------------------|-------------------------|----------|
| 1. Public Land Survey | T 44N. R 41W. | C-4a, 5 |
| | T _____ R _____ | 008 |
| | T _____ R _____ | 008 |
| | T _____ R _____ | 008 |
| 2. Property Controlling in Section | S _____ T _____ R _____ | REP. |
| | S _____ T _____ R _____ | 10/18/98 |
| 3. Miscellaneous Property in Sec. | S _____ T _____ R _____ | |
| | S _____ T _____ R _____ | |

4. Lot No. _____, Recorded **PEER GROUP**
5. Private Claims _____ **Approved**

Richard R. Dralun 4/7/94

Gary L. Pisoni December 30, 1993

I, Gary L. Pisoni, in a field survey on December 30, 1993, do hereby certify that under requirements of P.A. 74, Michigan P.A. of 1970, the corner points mentioned in lines 1 and 2 above were in conformance with regulations and rules therefore as required in the current manual of survey instructions of the United States Department of the Interior, Bureau of Land Management or by a decree of a Court of Law and/or that the corner points mentioned in lines 3, 4 and 5 above were in conformance with the rules of the Michigan Board of Land Surveyors or by a Decree of a Court of Law, established, re-established, monumented, re-monumented, recovered, found as expressed below:

NOTE: Not more than 4 corners, all in the same town and range, may be recorded on this certificate.

| A | B | C | D | E | F | G | H | I | J | K | L | M |
|----|----|----|----|----|----|----|---|---|---|---|---|---|
| 2 | 6 | 5 | 4 | 3 | 2 | 1 | | | | | | |
| 3 | | | | | | | | | | | | |
| 4 | 7 | 8 | 9 | 10 | 11 | 12 | | | | | | |
| 5 | | | | | | | | | | | | |
| 6 | 18 | 17 | 16 | 15 | 14 | 13 | | | | | | |
| 7 | | | | | | | | | | | | |
| 8 | 19 | 20 | 21 | 22 | 23 | 24 | | | | | | |
| 9 | | | | | | | | | | | | |
| 10 | 30 | 29 | 28 | 27 | 26 | 25 | | | | | | |
| 11 | | | | | | | | | | | | |
| 12 | 31 | 32 | 33 | 34 | 35 | 36 | | | | | | |
| 13 | | | | | | | | | | | | |

A. Description of original monument and accessories and/or subsequent restoration:

Original Corner established by Algernon Merryweather, U.S. Deputy Surveyor on July 11, 1852.
Original Corner: Wood post
Original Bearing Tree: Alder 3" N 20°E 46 links (30.36 feet)


B. Description of corner evidence found and/or method applied in restoring or reestablishing corner:

No original corner evidence found. I restored the meander corner position on the North shore of Brown Lake on line between the East quarter corner and the Southeast Section corner of Section 7.
Monument located 55 feet from edge of shoreline.

C. Description of monument for corner and accessories established to perpetuate locating the position of the corner:

At the corner position, I set a 3/4" outside diameter by 4 feet long aluminum rod monument with a 3" cast aluminum cap, stamped to read: T44N, R41W, S-7, S-8, M.C., 1992, RLS- 27457 from which I established the following new blazed and scribed bearing trees: (all measurements taken to a nail in side of tree)

| | | | |
|-----------------|----|--------|------------|
| Ash | 5" | N 79°W | 4.24 feet |
| Ash | 5" | S 59°E | 20.32 feet |
| Ash | 7" | N 32°E | 21.23 feet |
| Steel Sign Post | | South | 0.97 feet |

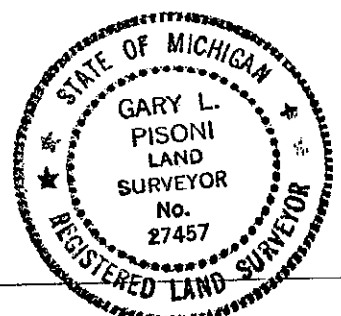

Signed by Gary L. Pisoni

Date 3-22-94

Surveyor's Michigan License No. 27457