

LAND CORNER RECORDATION CERTIFICATE  
Filing Requirement of Act 74, Mich. P.A. 1970

Register's Office }  
Gogebic County } ss.

For corners in

Gogebic  
(County)

Located In:

Corner Code: 11

1. Public Land Survey

~~T46N~~ T45N R40W

B-1,2e

T R

005

T R

T R

2. Property Controlling  
in Section

S T T46N R 40W

ONT. COUNTY

S T R

3. Miscellaneous

S T R

Property in Sec:

S T R

Received for record the  
11<sup>TH</sup> day of AUGUST

A. D. 1993 at 4:15 o'clock

A m., and recorded in  
Liber 4 of CORNERS

on page 248

Betty L. Lash Deputy  
Register of Deeds

Register of Deeds Stamp & File Number

4. Lot No. \_\_\_\_\_, Recorded Plat \_\_\_\_\_

5. Private Claims \_\_\_\_\_

31.61 CHS. WEST

I, Gary L. Pisoni, in a field survey on March 29, 1991,  
do hereby certify that under requirements of P.A. 74, Michigan P.A. of 1970, the corner points mentioned  
in lines 1 and 2 above were in conformance with regulations and rules therefore as required in the  
current manual of survey instructions of the United States Department of the Interior, Bureau of Land  
Management or by a decree of a Court of Law and/or that the corner points mentioned in lines 3, 4 and 5  
above were in conformance with the rules of the Michigan Board of Land Surveyors or by a Decree of a  
Court of Law; established, re-established, monumented, re-monumented, recovered, found as  
expressed below:

NOTE: Not more than 4 corners, all in the same town and range, may be recorded  
on this certificate.

A. Description of original monument and accessories and/or subsequent restoration:

Original corner established by John Burt, U.S. Deputy Surveyor in July 9, 1847.

Original corner: 12" Hemlock as corner tree

No original bearing tree set.

B. Description of corner evidence found and/or method applied in restoring or reestablishing corner:


No original corner evidence found. Corner restored by single proportionate  
measurement methods on line between the Northwest corner of Section 6, T45N, R40W  
and the East meander corner between Sections 32 and 5.

C. Description of monument for corner and accessories established to perpetuate locating the position of the corner:

At the corner position, I set a standard 2" diameter by 30" long split base aluminum  
pipe monument with a 3" cast aluminum cap, stamped to read: T46N, R40W, S-31, S-6, M.C.,  
T45N, R.L.S. 27457; from which I established the following new blazed and scribed  
bearing trees: (all measurements taken to a nail in side of tree) 21' from water's edge

Cedar	7"	N 38° W	19.80 feet
Black Spruce	6"	N 79° E	20.63 feet
White Pine	16"	S 68° E	23.06 feet
Steel sign post		South	0.76 feet

PEER GROUP APPROVED  
Richard L. Deahn 1/20/94  
COUNTY REPRESENTATIVE

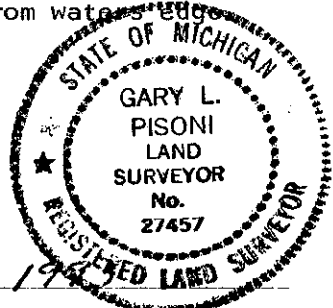

Signed by Gary L. Pisoni

Date

August 6<sup>th</sup>, 1993

Surveyor's Michigan License No. 27457

U.S.F.S. #A-3,4e