

LAND CORNER RECORDATION CERTIFICATE
Filing Requirement of Act 74, Mich. P.A. 1970

For corners in
Gogebic
(County)

Located In:

Corner Code 77

1. Public Land Survey

T 45N R 40W

G-H, 3w

006

2. Property Controlling
in Section

S T R

3. Miscellaneous

S T R

Property in Sec.

S T R

4. Lot No. , Recorded Plat

5. Private Claims

West Meander Corner between Sections 3 and Section 10.

I, Gary L. Pisoni, in a field survey on December 14 19 92,
do hereby certify that under requirements of P.A. 74, Michigan P.A. of 1970, the corner points mentioned
in lines 1 and 2 above were in conformance with regulations and rules therefore as required in the
current manual of survey instructions of the United States Department of the Interior, Bureau of Land
Management or by a decree of a Court of Law and/or that the corner points mentioned in lines 3, 4 and 5
above were in conformance with the rules of the Michigan Board of Land Surveyors or by a Decree of a
Court of Law; established, re-established, monumented, re-monumented, recovered, found as
expressed below:

NOTE: Not more than 4 corners, all in the same town and range, may be recorded
on this certificate.

A. Description of original monument and accessories and/or subsequent restoration:

Original corner established by Wells Burt, U.S. Deputy Surveyor on July 27, 1851.

Original corner: 14" Cedar as corner tree

No original bearing trees set.

B. Description of corner evidence found and/or method applied in restoring or reestablishing corner:

No original corner evidence found. Corner restored by single proportionate
measurement methods on line between the Northwest corner of Section 10 and
the North quarter corner.

C. Description of monument for corner and accessories established to perpetuate locating the position of the corner:


At the corner position, I set a 3/4" outside diameter by 4 feet long aluminum rod
monument with a 3" cast aluminum cap, stamped to read: T45N, R40W, S-3, S-10, M.C.,
1992, R.L.S. 27457; from which I established the following new blazed and scribed
bearing trees: (all measurements taken to a nail in side of tree)

Hemlock	9"	S 21° E	22.23 feet
Sugar Maple	8"	S 63° E	15.63 feet
Hemlock	5"	N 17° W	22.85 feet
Steel sign post		West	1.05 feet

PEER GROUP APPROVED

Richard L. Neahr 1/20/94

COUNTY REPRESENTATIVE

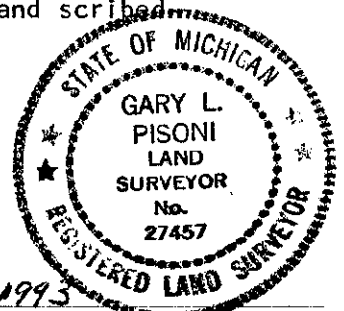

Signed by Gary L. Pisoni
Surveyor's Michigan License No. 27457

Date August 6th, 1993

Register's Office }
Gogebic County } ss.

Received for record the
11th day of AUGUST

A. D. 19 93 at 9:15 o'clock

A m., and recorded in

Liber 4 of CORNERS

on page 249

Betty Isaac Deputy
Register of Deeds

Register of Deeds Stamp & File Number

	A	B	C	D	E	F	G	H	I	J	K	L	M
2	6	5	4	3	2	1							
3													
4	7	8	9	10	11	12							
5													
6	18	17	16	15	14	13							
7													
8	19	20	21	22	23	24							
9													
10	30	29	28	27	26	25							
11													
12	31	32	33	34	35	36							