

SURVEY & REMONUMENTATION

AUG 08 1997

COMMISSION

LAND CORNER RECORDATION CERTIFICATE Filing Requirement of Act 74, Mich. P.A. 1970

For corners in

Gogebic

(County)

Located In:

Corner Code ##

1. Public Land Survey

T 45N R 45W

AB 4-5

T R

T R

T R

T R

2. Property Controlling
in Section

S T R

S T R

3. Miscellaneous

S T R

Property in Sec.

S T R

4. Lot No. , Recorded Plat

5. Private Claims

Mile Corner # 7, Mich---Wisc. State Line

I, Richard L. Drahn in a field survey on June 3, 1997, do hereby certify that under requirements of P.A. 74, Michigan P.A. of 1970, the corner points mentioned in lines 1 and 2 above were in conformance with regulations and rules therefore as required in the current manual of survey instructions of the United States Department of the Interior, Bureau of Land Management or by a decree of a Court of Law and/or that the corner points mentioned in lines 3, 4 and 5 above were in conformance with the rules of the Michigan Board of Land Surveyors or by a Decree of a Court of Law; established, re-established, monumented, re-monumented, recovered, found as expressed below:

NOTE: Not more than 4 corners, all in the same town and range, may be recorded on this certificate.

A. Description of original monument and accessories and/or subsequent restoration:

Corner established by William Burt in 1847. Original B.T.s --- Sugar 10" S.61 W. 39 links (25.74') --- Sugar 9" N.27 W. 20 links (13.20') ---

Corner restored by Earl G. Harrington from the live, still scribed "18' Maple" bearing N.27 W. 13.2 ft. and a decayed Maple stump at S.61 W. 25.7'. In 1928 he set a standard brass capped concrete monument and two new B.T.S --- Maple 14" N.29 E. 7.3 ft. --- Maple 24" S.04-40 E. 23.1 ft.---

Research form on file with Gogebic County records.

B. Description of corner evidence found and/or method applied in restoring or reestablishing corner:

Recovered the 1928 standard brass capped concrete monument as described in Harringtons notes. His N.29 E. B.T. is now a 18-20" badly decayed Sugar Maple stump. His S.04-40 E. B.T. is now a large deep stump hole.

A deep stump hole at N.27 W., 13.2' is all that remains of Burts 1847 B.T.s.

C. Description of monument for corner and accessories established to perpetuate locating the position of the corner:

From the above described concrete monument I established the following:

| | | | |
|----|-----------------|---------|-----------|
| 6" | Sugar Maple | N.51 W. | 50.56 ft. |
| 5" | Sugar Maple | N.07 E. | 30.46 ft. |
| 6" | Yellow Birch | N.73 E. | 14.02 ft. |
| 6' | Steel sign rail | N.29 E. | 1.93 ft. |

Register's Office } ss.
Gogebic County }

Received for record the

11TH day of JUNE

A. D. 1997 at 10:45 o'clock


A m., and recorded in

Lib. 6 of CORNER

on page 148

Colleen M. Rich, Deputy
Register of Deeds

Register of Deeds Stamp & File Number

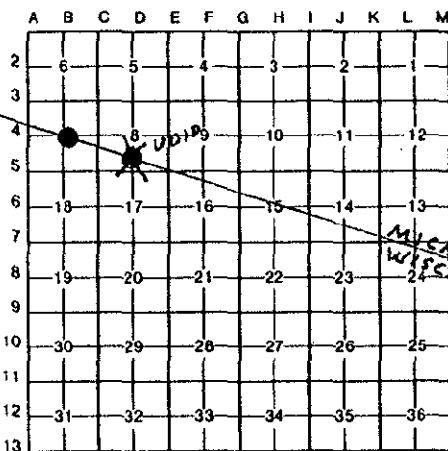

PEER GROUP APPROVED

Richard L. Drahn 6/10/97
COUNTY REPRESENTATIVE

Signed by Richard L. Drahn

Date June 5, 1997

Surveyor's Michigan License No. 21564

