

SURVEY &  
REMONUMENTATION

AUG 08 1997

COMMISSION

LAND CORNER RECORDATION CERTIFICATE  
Filing Requirement of Act 74, Mich. P.A. 1970

For corners in

Gogebic  
(County)

Located In:

Corner Code ##

1. Public Land Survey

T 45N R 46W

JK-3-4

13-2-3

T R

T R

T R

T R

2. Property Controlling  
in Section

S T R

S T R

3. Miscellaneous

S T R

Property in Sec.

S T R

4. Lot No. , Recorded Plat

5. Private Claims

Mile Corner #5, Mich.---Wisc. State Line

Richard L. Drahn in a field survey on May 21, 19 97, do hereby certify that under requirements of P.A. 74, Michigan P.A. of 1970, the corner points mentioned in lines 1 and 2 above were in conformance with regulations and rules therefore as required in the current manual of survey instructions of the United States Department of the Interior, Bureau of Land Management or by a decree of a Court of Law and/or that the corner points mentioned in lines 3, 4 and 5 above were in conformance with the rules of the Michigan Board of Land Surveyors or by a Decree of a Court of Law; established, re-established, monumented, re-monumented, recovered, found as expressed below:

NOTE: Not more than 4 corners, all in the same town and range, may be recorded on this certificate.

A. Description of original monument and accessories and/or subsequent restoration:

Corner established by William Burt in 1847. Original B.T.s --- Hemlock 9" N.24 W. 14 links (9.24') --- Y. Birch 10" S.46 E. 13 links (8.58') ---

Corner restored in 1928 by Earl G. Harrington from the two live original bearing trees, the Y. Birch was still scribed. He set a standard brass capped concrete monument and one new B.T. --- Spruce 8" S.12 E. 7.3 ft. ---

Research form on file with Gogebic County records.

B. Description of corner evidence found and/or method applied in restoring or reestablishing corner:

Recovered the 1928 standard brass capped concrete monument as described in Harringtons notes. A wind thrown stump hole is all that remains of the 1928 bearing tree.

Recovered a stump hole with Hemlock bark at N.24 W. 9.2 ft. and a large Y. Birch decayed to below ground line at S.46 E. 8.58 ft. from the 1847 original survey..

C. Description of monument for corner and accessories established to perpetuate locating the position of the corner:


From the above described concrete monument I established the following:

|     |                 |         |           |
|-----|-----------------|---------|-----------|
| 7"  | Sugar Maple     | N.59 W. | 23.32 ft. |
| 10" | Sugar Maple     | N.59 E. | 37.70 ft. |
| 8"  | Sugar Maple     | S.05 W. | 12.39 ft. |
| 6'  | Steel sign rail | N.20 E. | 2.11 ft.  |

Register's Office  
Gogebic County ss.

Received for record the  
11<sup>TH</sup> day of JUNE  
A. D. 1997 at 10:45 o'clock  
A m., and recorded in  
Lib. 6 of CORNERS  
on page 153  
Colleen M. Kichak, Deputy  
Register of Deeds

Register of Deeds Stamp & File Number

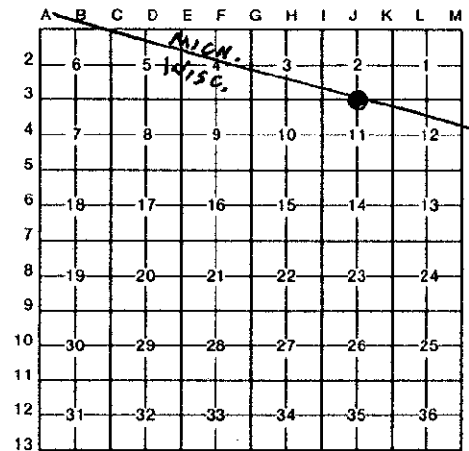

PEER GROUP APPROVED  
Richard L. Drahn 6/10/97  
COUNTY REPRESENTATIVE



Signed by Richard L. Drahn Date June 15, 1997

Surveyor's Michigan License No. 21564

USFS DE 17-18  
EF-14-20

153