

# SURVEY &

# REMONUMENTATION

AUG 08 1997

## COMMISSION

### LAND CORNER RECORDATION CERTIFICATE Filing Requirement of Act 74, Mich. P.A. 1970

Register's Office } ss.  
Gogebic County }

Received for record the  
16<sup>th</sup> day of JULY  
A. D. 1997 at 1:40 o'clock  
P. M., and recorded in  
Lib. 6 of CORNERS  
on page 165  
Colleen M. K. K. K.  
Deputy Register of Deeds

Register of Deeds Stamp & File Number

For corners in

Gogebic  
(County)

Located In:

Corner Code #

- |                         |             |        |
|-------------------------|-------------|--------|
| 1. Public Land Survey   | T 45N R 46W | GH-2-3 |
|                         | T R         |        |
|                         | T R         | 008    |
|                         | T R         |        |
| 2. Property Controlling | S T R       |        |
| in Section              | S T R       |        |
| 3. Miscellaneous        | S T R       |        |
| Property in Sec.        | S T R       |        |

4. Lot No. \_\_\_\_\_, Recorded Plat \_\_\_\_\_  
5. Private Claims \_\_\_\_\_

Mile Corner No. 3½; Mich. --- Wisc. State Line

I, Richard L. Drahn in a field survey on June 22, 1997, do hereby certify that under requirements of P.A. 74, Michigan P.A. of 1970, the corner points mentioned in lines 1 and 2 above were in conformance with regulations and rules therefore as required in the current manual of survey instructions of the United States Department of the Interior, Bureau of Land Management or by a decree of a Court of Law and/or that the corner points mentioned in lines 3, 4 and 5 above were in conformance with the rules of the Michigan Board of Land Surveyors or by a Decree of a Court of Law; established, re-established, monumented, re-monumented, recovered, found as expressed below:

**NOTE: Not more than 4 corners, all in the same town and range, may be recorded on this certificate.**

#### A. Description of original monument and accessories and/or subsequent restoration:

Corner established by William Burt in 1847. Original B.T.s --- W. Pine 24" N.28 W. 54 links (35.64') --- Y. Birch 18" S.47 E. 40 links (26.40') ---

Corner restored by Earl Harrington in 1928 from the stump remains of the two original B.T.s. He set a standard State Line concrete, brass capped monument and two new B.T.S: --- Cedar 8" S.03 W. 8.6' --- Spruce 10" N.41-30 E. 25.1' ---

On 5/8/85 Daniel K. Pleoger, Wisc. #S-1537 recovered the State Line monument and the stump remains of the 1847 B.T.s He set 4 new B.T.s (see item C below).

#### B. Description of corner evidence found and/or method applied in restoring or reestablishing corner:

Recovered the standard brass capped concrete monument as described in Earl Harrington's notes. His Cedar B.T. at S.03 W. is now a live 19" cedar with scribing visible. No evidence remains of his Spruce B.T. at N.41-30 E.

William Burts W. Pine B.T. is now a decayed 28- 30" W. Pine stump. No evidence remains of the Y. Birch at S.47 E.

Research Form on file with Gogebic County records.

Recovered Pleoger's B.T.s as listed in parentheses below. Distances are to a new 10p nail in the side of the B.T.


PEER GROUP APPROVED

Richard L. Drahn 7/15/97  
COUNTY REGISTER

#### C. Description of monument for corner and accessories established to perpetuate locating the position of the corner:

From the above described concrete monument I recovered the following new bearing trees by Daniel K. Pleoger:

- |           |                 |                  |                 |
|-----------|-----------------|------------------|-----------------|
| 6" (9")   | Red Maple       | N.05 W (N.04 W.) | 33.14' (33.05') |
| 9" (9")   | Red Maple       | S.65 W.(S.67 W.) | 18.43' (18.35') |
| 12" (13") | Cedar           | S.30 W.(S.30 W.) | 10.72' (10.52') |
| 20" (20") | Cedar           | S.29 E.(S.29 E.) | 50.53' (50.35') |
| 6'        | Steel sign rail | N.38 E.          | 1.78'           |

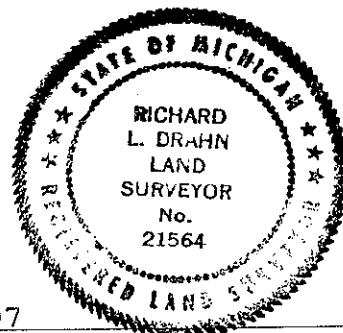

Signed by Richard L. Drahn

Date July 3, 1997

Surveyor's Michigan License No. 21564