

LAND CORNER RECORDATION CERTIFICATE
Filing Requirement of Act 74, Mich. P.A. 1970

For corners in

Gogebic

(County)

Located In:

Corner Code #

1. Public Land Survey

T46N R44W

J-3

T R

T R

T R

T R

S T

S T

S T

**SURVEY &
REMONUMENTATION**

JAN 05 2001

SECTION

2. Property Controlling
in Section

3. Miscellaneous
Property in Sec.

Register's Office }
Gogebic County }

Received for record the

26th day of MAY

A. D. 19 00 at 11:00 o'clock

4 m., and recorded in

Liber 7 of CORNERS

on page 318

Sheel Ruppe
Deputy Register of Deeds

Register of Deeds Stamp & File Number

4. Lot No. _____, Recorded Plat _____

5. Private Claims _____

1/4 corner common to 2 and 11, T46N, R44W

I, John P. Goss, in a field survey on Feb 29, 2000 do hereby state that under requirements of P.A. 74, Michigan P.A. of 1970, the corner points mentioned in lines 1 and 2 above were in conformance with regulations and rules therefore as required in the current manual of survey instructions of the United States Department of the Interior, Bureau of Land Management or by a decree of a Court of Law and/or that the corner points mentioned in lines 3, 4 and 5 above were in conformance with the rules of the Michigan Board of Land Surveyors or by a Decree of a Court of Law; established, re-established, monumented, recovered, found as expressed below:

NOTE: Not more than 2 corners, all in the same town and range, may be recorded on this certificate.

	A	B	C	D	E	F	G	H	I	J	K	L	M
1													
2		6		5		4		3		2		1	
3													
4		7		8		9		10		11		12	
5													
6		18		17		16		15		14		13	
7													
8		19		20		21		22		23		24	
9													
10		30		29		28		27		26		25	
11													
12		31		32		33		34		35		36	
13													

A. Description of original monument and accessories and/or subsequent restoration:
Corner established by Austin Burt, on August 22, 1851.

Original bearing trees: Sugar 12" S 17° W 54 links (35.64')
Sugar 12" N 46° E 24 links (15.84')

Richard L. Drahn, 21564, restored corner position at record bearing and distance from the remains of the two original bearing trees. He set a 2" aluminum monument with 3/4" aluminum cap, stamped to indicated the corner position. He established the following reference objects: 7" S. Maple - N 17° W - 40.37 ft.; 9" S. Maple - N 40° E - 16.73 ft.; 9" Red Maple - S 42° W - 34.34 ft.; 6' metal sign post bearing - S 35° E - 1.9 ft.

B. Description of corner evidence found and/or method applied in restoring or reestablishing corner:

He recorded said corner in Liber 2, page 234 of Land Corners, on 3-10-82.

Found Richard L. Drahn, monument and accessories.

Act 74 research on file.


Richard L. Drahn, restored this corner on 10-19-81.

PEER GROUP APPROVED
Richard L. Drahn 05/24/00
COUNTY SHERIFF J. F. B. J.

C. Description of monument for corner and accessories established to perpetuate locating the position of the corner:
From the found monument I established the following new and existing reference objects:

10" Sugar Maple	N 17° W	40.34 ft.
12" Sugar Maple	N 40° E	16.73 ft.
11" Red Maple	S 42° W	34.34 ft.
7" Tw. Sugar Maple	S 71° E	21.91 ft.
6' metal sign post	S 35° E	1.9 ft. to face

(All measurement taken to nail in side of tree)

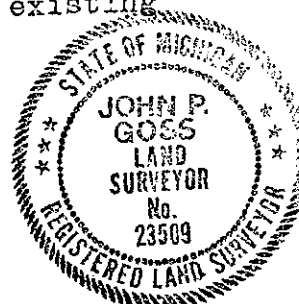

Signed by John P. Goss

Surveyor's Michigan License No. 23509

USFS # E-19

Date March 1, 2000