

## SECTION

**LAND CORNER RECORDATION CERTIFICATE**  
**Filing Requirement of Act 74, Mich. P.A. 1970**

**For corners in**

**Gogebic**  
(County)

**Located in:**

**Corner Code #**

- |                                  |                             |           |
|----------------------------------|-----------------------------|-----------|
| 1. Public Land Survey Section 13 | T <u>46</u> N <u>R 44</u> W | K-7 _____ |
|                                  | T _____ R _____             | _____     |
|                                  | T _____ R _____             | _____     |
|                                  | T _____ R _____             | _____     |
| 2. Property Controlling          | S _____ T _____ R _____     | _____     |
| in Section                       | S _____ T _____ R _____     | _____     |
| 3. Miscellaneous                 | S _____ T _____ R _____     | _____     |
| Property in Sec.                 | S _____ T _____ R _____     | _____     |

4. Lot No. \_\_\_\_\_, Recorded Plat \_\_\_\_\_  
5. Private Claims \_\_\_\_\_

**Section corner common to sections 13, 14, 23, 24**

I, John R. Garske, in a field survey on June 21, 1999 do hereby state that under requirements of P.A. 74, Michigan P.A. of 1970, the corner points mentioned in lines 1 and 2 above were in conformance with regulations and rules therefore as required in the current manual of survey instructions of the United States Department of the Interior, Bureau of Land Management or by a decree of a Court of Law and/or that the corner points mentioned in lines 3, 4 and 5 above were in conformance with the rules of the Michigan Board of Land Surveyors or by a Decree of a Court of Law; established, re-established, monumented, recovered, found as expressed below:

**NOTE:** Not more than 2 corners, all in the same town and range, may be recorded on this certificate.

**A. Description of original monument and accessories and/or subsequent restoration:**

Original survey by Austin Burt, D.S. in July 1851 Original Bearing Trees:

Original survey by Austin Buft, D.S. in  
 Fir 10" S58°W 25 links

y birch 16"	N60°E	14 links
-------------	-------	----------

Corner restored in 1975 by Richard Dra

filled pipe with a 3" dia. bronze cap stamped from which:

4" cherry S70°W 31.0 feet

6" red maple	N25°E	17.9	feet
--------------	-------	------	------

8" balsam	N23°E	17.9 feet
	N55°E	17. feet

7' metal sign post	NSS E south	17. feet 2.0 feet
--------------------	----------------	----------------------

B. Description of corner evidence found and/or method applied in restoring or reestablishing corner:

**I found the monument as described above. I set nails in the trees and recorded new ties as noted below.**

(Research on file)

**PEER GROUP APPROACH**

Richard L. Drath 8/24/99

COUNTY REPRESENTATION

C. Description of monument for corner and accessories established to perpetuate locating the position of the corner;


**Established the following witnesses:**

8" sugar N31°E 17.67 feet (existing)

11" balsam	N51°E	17.67	feet (existing)
Steel pipe	S50°E	17.21	feet (existing)

Steel sign post	S13°W	2.5 feet (existing)
-----------------	-------	---------------------

10" sugar S18°W 2.5 feet (existing)  
S29°W 33.83 feet (new)

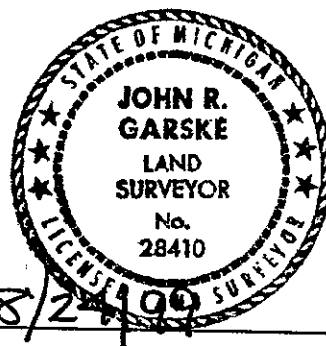

Signed by John K. Garcke  
Surveyor's Michigan License No. 28410

Date 8/24/99