

LAND CORNER RECORDATION CERTIFICATE Filing Requirement of Act 74, Mich. P.A. 1970

Register's Office } ss.
Gagebic County }

For corners in

GOGEBIC

(County)

Located in:

Corner Code #

1. Public Land Survey

T46N R44W K-9
T R
T R
T R SURVEY &
T R MONUMENTATION

2. Property Controlling
in Section

S T R
S T R
S T R
S T R

3. Miscellaneous
Property in Sec.

JAN 05 2001

SECTION

Received for record the
26TH day of MAY
A. D. 2000 at 11:10 o'clock
A. m., and recorded in
Liber 7 of CORNERS

page 327
Chester Rippe
Dep. Register of Deeds

Register of Deeds Stamp & File Number

4. Lot No. , Recorded Plat

5. Private Claims

Section corner, Sections 23, 24, 25 & 26, T46N, R44W

I, John P. Goss, in a field survey on May 3, 2000 do hereby state that under requirements of P.A. 74, Michigan P.A. of 1970, the corner points mentioned in lines 1 and 2 above were in conformance with regulations and rules therefore as required in the current manual of survey instructions of the United States Department of the Interior, Bureau of Land Management or by a decree of a Court of Law and/or that the corner points mentioned in lines 3, 4 and 5 above were in conformance with the rules of the Michigan Board of Land Surveyors or by a Decree of a Court of Law, established, re-established, monumented, recovered, found as expressed below:

NOTE: Not more than 2 corners, all in the same town and range, may be recorded on this certificate.

	A	B	C	D	E	F	G	H	I	J	K	L	M
1													
2	6		5		4		3		2		1		
3													
4	7		8		9		10		11		12		
5													
6	18		17		16		15		14		13		
7													
8	19		20		21		22		23		24		
9													
10	30		29		28		27		26		25		
11													
12	31		32		33		34		35		36		
13													

A. Description of original monument and accessories and/or subsequent restoration:

Corner established by Austin Burt, in 1851.

Original bearing trees: Cedar 10" S 15° W 5 links (3.96 ft.)
Cedar 10" N 10° E 7 links (4.62 ft.)

Donald D. Lappala, 12585, on October 19, 1967, found position marked by 3"x3"x48 cedar post at record bearing and distance from the remains of the original bearing trees. Further verified by measurements along section line south and north from corner to recoverable record natural features. He set a 2" I.D. iron pipe with 3" bronze tablet, stamped to indicated the corner position. He established the following reference objects: 4" Cedar - N72°W-7.6 ft.; 4"Cedar-N06°E-16.9 ft

B. Description of corner evidence found and/or method applied in restoring or reestablishing corner:

4" Cedar-S63°W-13.1 ft.

On June 6, 1968, he recorded said corner in U.S.F.S. Liber, Index No. R-21.

No original evidence found.

Found Donald D. Lappala, monument and accessories.


Act 74 research on file.

DEED GROUP APPROVED
Richard L. Dralun 05/24/00
COURT REPERCUSSION

C. Description of monument for corner and accessories established to perpetuate locating the position of the corner:

From the found monument, stamped to read: T.46 N., R.44 W.; S-23, S-24, S-25, S-26; R.L.S. 12585; 1967; from which I established the following existing and new reference objects:

7" Cedar N 72° W 7.39 ft.
8" Cedar N 06° E 16.98 ft.
7" Cedar S 63° W 12.82 ft.
4"x4" wood sign post S 80° E 2.38 ft. to face
6" rail & sign N 35° E 2.07 ft. to face
(All measurement taken to nail in side of tree)

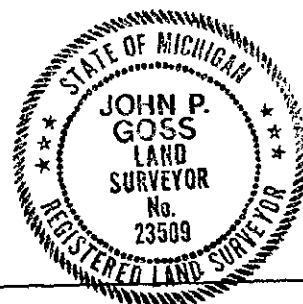

Signed by John P. Goss

Date May 4, 2000

Surveyor's Michigan License No. 23509

U.S.F.S. No. R-21