

# SURVEY & REMONUMENTATION

AUG 08 1997

COMMISSION

## LAND CORNER RECORDATION CERTIFICATE Filing Requirement of Act 74, Mich. P.A. 1970

Register's Office } ss.  
Gogebic County }

For corners in

Gogebic

(County)

Located In:

Corner Code #

1. Public Land Survey

T46NR43W A 9-10 001  
T46NR44W M 9-10 001

2. Property Controlling  
in Section

S T R

3. Miscellaneous  
Property in Sec.

S T R  
S T R

4. Lot No. , Recorded Plat

5. Private Claims

M.C. to sec's 25 & 30

I, John P. Goss, in a field survey on June 14, 1997 do hereby state that under requirements of P.A. 74, Michigan P.A. of 1970, the corner points mentioned in lines 1 and 2 above were in conformance with regulations and rules therefore as required in the current manual of survey instructions of the United States Department of the Interior, Bureau of Land Management or by a decree of a Court of Law and/or that the corner points mentioned in lines 3, 4 and 5 above were in conformance with the rules of the Michigan Board of Land Surveyors or by a Decree of a Court of Law; established, re-established, monumented, recovered, found as expressed below:

NOTE: Not more than 2 corners, all in the same town and range, may be recorded on this certificate.

| A  | B  | C | D  | E | F  | G | H  | I | J  | K | L  | M |
|----|----|---|----|---|----|---|----|---|----|---|----|---|
| 1  |    |   |    |   |    |   |    |   |    |   |    |   |
| 2  | 6  |   | 5  |   | 4  |   | 3  |   | 2  |   | 1  |   |
| 3  |    |   |    |   |    |   |    |   |    |   |    |   |
| 4  | 7  |   | 8  |   | 9  |   | 10 |   | 11 |   | 12 |   |
| 5  |    |   |    |   |    |   |    |   |    |   |    |   |
| 6  | 10 |   | 17 |   | 16 |   | 15 |   | 14 |   | 13 |   |
| 7  |    |   |    |   |    |   |    |   |    |   |    |   |
| 8  | 19 |   | 20 |   | 21 |   | 22 |   | 23 |   | 24 |   |
| 9  |    |   |    |   |    |   |    |   |    |   |    |   |
| 10 | 30 |   | 29 |   | 28 |   | 27 |   | 26 |   | 25 |   |
| 11 |    |   |    |   |    |   |    |   |    |   |    |   |
| 12 | 31 |   | 32 |   | 33 |   | 34 |   | 35 |   | 36 |   |
| 13 |    |   |    |   |    |   |    |   |    |   |    |   |

A. Description of original monument and accessories and/or subsequent restoration:

Original corner established by Austin Burt on Aug. 8, 1847. Set Cedar post.  
Original bearing trees: Tamarack 18" N 40° E 13 links  
Tamarack 16" N 22° W 23 links.

Richard Drahn, RLS, on May 23, 1975. Restored corner position at record bearing and distance from the stump remains of the two (2) original bearing trees. He set a 2" iron pipe with 3" cap stamped to indicated corner position, with the following references: 3" Cedar- N 42° E- 4.7'; 6" Cedar- N 83° E- 20.6'; 5" Cedar- S 65° E- 17.4'; 7' Metal sign post- N 14° W- 2.8', and recorded it in Liber 1, page 160 of Land corners for Gogebic County.

B. Description of corner evidence found and/or method applied in restoring or reestablishing corner:

Found Richard Drahn, 2" iron pipe with 3" bronze tablet. It checked with his witnesses. I updated the accessories as noted below to state and county specification.

Act 74 research on file.


PEER GROUP APPROVED

Richard L. Drahn 7/15/97  
COUNTY REPRESENTATIVE

C. Description of monument for corner and accessories established to perpetuate locating the position of the corner:

From the 2" I.D. iron pipe with 3" circular bronze tablet which read: T.46 N., R. 43-44 W.; M.C.; S-25, S-30; R.L.S. 21564; 1975. I established the following existing and new bearing trees and reference objects.

5" Cedar N 42° E 4.72'  
7" Cedar N 83° E 20.58'  
6" Cedar S 65° E 17.28'  
4" Cedar N 50° W 28.20'  
7' Metal sign post N 14° W 2.7' ( to face of post)  
6' Rail & Sign N 56° E 3.0' ( to face of rail)

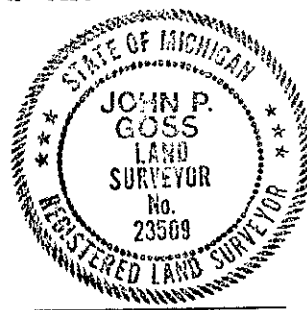

Signed by John P. Goss

Date June 15, 1997

Surveyor's Michigan License No. 23509

Fed. No. ST - 25