

SURVEY &  
REMONUMENTATION

APR 05 1996

COMMISSION

LAND CORNER RECORDATION CERTIFICATE  
Filing Requirement of Act 74, Mich. P.A. 1970

For corners in

Ontonagon/Gogebic

(County)

Located In:

Corner Code #

1. Public Land Survey ONTONAGON T 48N R 42W E-F-13  
Gogebic T 47N R 42W E-F-1 001
2. Property Controlling S T R Other #1  
in Section S T R  
3. Miscellaneous S T R  
Property in Sec. S T R

4. Lot No. , Recorded Plat

5. Private Claims

Meander corner common to Section 33, T48N, R42W and  
Section 4, T47N, R42W.

I, John R. Garske, in a field survey on October 22, 19 94,  
do hereby certify that under requirements of P.A. 74, Michigan P.A. of 1970, the corner points mentioned  
in lines 1 and 2 above were in conformance with regulations and rules therefor as required in the  
current manual of survey instructions of the United States Department of the Interior, Bureau of Land  
Management or by a decree of a Court of Law and/or that the corner points mentioned in lines 3, 4 and 5  
above were in conformance with the rules of the Michigan Board of Land Surveyors or by a Decree of a  
Court of Law; established, re-established, monumented, re-monumented, recovered, found as  
expressed below:

NOTE: Not more than 4 corners, all in the same town and range, may be recorded  
on this certificate.

A. Description of original monument and accessories and/or subsequent restoration:

Survey by John and Wm. Burt on August 10-14, 1847. Set a cedar post from which a 12"  
hemlock bears N32°E, 12 links and a 10" hemlock - S69°E, 25 links.

1964 plat of Lake Gogebic East Shore Subdivision No. 1 - Corner is a 4" concrete monument with  
a 1/2" iron rod. This corner has been used in several surveys by various surveyors.

B. Description of corner evidence found and/or method applied in restoring or reestablishing corner:

Found 4" concrete monument as noted above. Accepted corner as shown on the plt as being the  
meander corner due to its use, longevity and the development referenced to it.

Corner record research on file.

Register's Office  
Gogebic County

Received for record the  
6<sup>TH</sup> day of DECEMBER  
A. D. 1994 at 10:00 o'clock  
4 m., and recorded in  
Liber 5 of CORNER  
on page 164  
Ramona Collins, Deputy  
Register of Deeds

Register of Deeds Stamp & File Number

	A	B	C	D	E	F	G	H	I	J	K	L	M
2	6	5	4	3	2	1							
3													
4	7	8	9	10	11	12							
5													
6	16	17	18	15	14	13							
7													
8	19	20	21	22	23	24							
9													
10	30	29	28	27	26	25							
11													
12	31	32	33	34	35	36							
13													

PEER GROUP

Approved

Richard P. Wedin


11/30/94

C. Description of monument for corner and accessories established to perpetuate locating the position of the corner:

I updated the corner position to state and county specifications by placing a 3 1/4" aluminum cap  
atop the concrete monument and stamped the cap as follows: County Remonumentation; M.C.; S-  
33; S-4; T48-47N, R42W; 1994; RLS 28410. I established the following bearing trees and  
reference objects: 4" cedar - N50°W, 7.86 feet; 3" cedar - S27°W, 9.63 feet; 4" balsam fir -  
S27°E, 20.29 feet; 6 foot steel rail with sign - Due North, 1.60 feet.

Signed by John R. Garske  
Surveyor's Michigan License No. 28410

Date 12/5/94

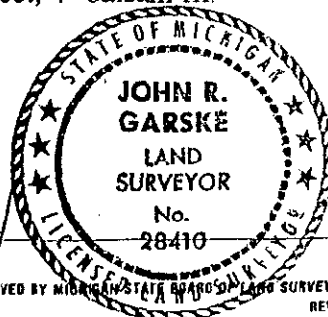

FORM APPROVED BY MICHIGAN STATE BOARD OF LAND SURVEYORS, JAN. 28, 1971  
REVISED MAY 14, 1975  
REVISED JAN., 1983