

LAND CORNER RECORDATION CERTIFICATE
Filing Requirement of Act 74, Mich. P.A. 1970

Register's Office }
 Gogebic County } ss.

For corners in
Gogebic

(County)

Located In: Corner Code #

Received for record the
21st day of JULY

A. D. 1995 at 1:40 o'clock

P m., and recorded in
 Liber 5 of CORNERS

on page 272

Ramona Collins, Deputy
 Register of Deeds

Register of Deeds Stamp & File Number

1. Public Land Survey	T <u>47N</u> R <u>46W</u>	<u>E-5</u>
	T _____ R _____	_____
	T _____ R _____	_____
	T _____ R _____	_____
2. Property Controlling in Section	S _____ T _____ R _____	_____
	S _____ T _____ R _____	_____
3. Miscellaneous Property in Sec.	S _____ T _____ R _____	_____
	S _____ T _____ R _____	_____

4. Lot No. _____, Recorded Plat _____
 5. Private Claims _____

Section Corner Comm. to Sec's. 8,9,16 & 17

I, John P. Goss, in a field survey on June 16, 1995, do hereby certify that under requirements of P.A. 74, Michigan P.A. of 1970, the corner points mentioned in lines 1 and 2 above were in conformance with the regulations and rules thereof in the current manual of survey instructions of the United States Department of the Interior, Bureau of Land Management or by a decree of a Court of Law and/or that the corner points mentioned in lines 3, 4 and 5 above were in conformance with the rules of the Michigan Board of Land Surveyors or by a Decree of a Court of Law; established, re-established, monumented, re-monumented, recovered, found as expressed below:

NOTE: Not more than 4 corners, all in the same town and range, may be recorded on this certificate.

A. Description of original monument and accessories and/or subsequent restoration:

Original corner established by Austin Burt on June 19, 1851. Set post.
 Original bearing trees: Spruce 8" S 19° E 16 links
 W. Pine 6" N 54° W 7 links

John P. Goss in 1978 using MDOT Plat found 1½" iron pipe and recorded it in Liber 2 on page 383 of Land Corners for Gogebic County. Established the following witnesses and distances: 7" Maple- S43°W-26.39'; 5" Cherry- S 06° W- 52.31'; 4" Cherry- S 53° E- 27.70'.

B. Description of corner evidence found and/or method applied in restoring or reestablishing corner:

I found the 1½" iron pipe marking the corner position and it checked with the witnesses in John P. Goss certification. I Updated the corner monument and accessories as noted below to state and county specification.

Act 74 reseach on file with the County Register of Deeds Office.


PEER GROUP APPROVED

Richard P. ... 7/18/95
 COUNTY REPRESENTATIVE

C. Description of monument for corner and accessories established to perpetuate locating the position of the corner:

I replaced the 1½" iron pipe with a 2½" x 30" aluminum pipe with a 3½" aluminum cap stamped as follows: County Remonumentation; S-8, S-9, S-16, S-17; T.47N, R46W; 1995; P.S. 23509. I established the following bearing trees and reference objects.

- 11" Maple S 43° W 26.39'
- 3" Cherry N 28° W 8.22'
- 4" Cherry S 63° E 16.10'
- 6' steel rail and sign N 80° E 2.37'

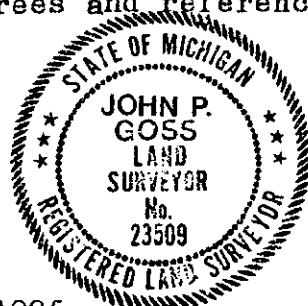

Signed by John P. Goss Date June 23, 1995
 Surveyor's Michigan License No. P.S. 23509