

LAND CORNER RECORDATION CERTIFICATE
Filing Requirement of Act 74, Mich. P.A. 1970

For corners in

Gogebic
(County)

Located In:

Corner Code #

1. Public Land Survey S-5 T 47N R 46W C-1
T 48N R 46W C-13
T _____ R _____
T _____ R _____
2. Property Controlling S _____ T _____ R _____
in Section S _____ T _____ R _____
3. Miscellaneous S _____ T _____ R _____
Property in Sec. S _____ T _____ R _____

4. Lot No. _____, Recorded Plat _____

5. Private Claims _____

Section corner common to Sections 5 and 6, T47N, R46W and
Sections 31 and 32, T48N, R46W.

I, John R. Garske, in a field survey on September 6, 19 95,
do hereby certify that under requirements of P.A. 74, Michigan P.A. of 1970, the corner points mentioned
in lines 1 and 2 above were in conformance with regulations and rules therefore as required in the
current manual of survey instructions of the United States Department of the Interior, Bureau of Land
Management or by a decree of a Court of Law and/or that the corner points mentioned in lines 3, 4 and 5
above were in conformance with the rules of the Michigan Board of Land Surveyors or by a Decree of a
Court of Law; established, re-established, monumented, re-monumented, recovered, found as
expressed below:

**NOTE: Not more than 4 corners, all in the same town and range, may be recorded
on this certificate.**

A. Description of original monument and accessories and/or subsequent restoration:

On September 9, 1847, William A. Burt established a 6" sugar as a corner tree, from which a 12" sugar bears N43°E, 36 links;
12" sugar - N12°W, 31 links
20" sugar - S55°E, 50 links
6" sugar - S53°W, 17 links

Survey by William Riipi, RLS, dated 4-5-76 - Found 1" iron pin at corner location Plat of Big Powderhorn Mountain.

B. Description of corner evidence found and/or method applied in restoring or reestablishing corner:

No corner evidence of the corner could be found due to ski hill construction. I was able to reestablish the corner position by use of
recorded plats and survey information provided by Riipi. Including dimension shown on the Plat of Alpen Village and monuments
found within the Plat.


Corner record research on file with County Register of Deeds.

C. Description of monument for corner and accessories established to perpetuate locating the position of the corner:

Set a 3/4" diameter x 14" long aluminum rod with a 3 1/4" diameter aluminum cap grouted in rock, stamped: County
Remonumentation; T48N, R46W; S-31; S-32; S-6; S-5; T47N; 1995; RLS 28410, from which I established the following bearing
trees and/or reference objects:

Light pole - N19°E, 95.76 feet
Light pole - S41°W, 111.90 feet
7" aspen - S67°E, 140.45 feet
5" sugar - N45°W, 48.30 feet

PEER GROUP APPROVAL
Richard G. Drake 9/20/95
COUNTY REPRESENTATIVE

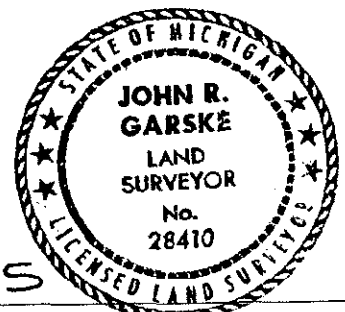

Signed by John R. Garske

Date 9-15-95

Surveyor's Michigan License No. 28410