

SURVEY & MONUMENTATION

MAY 16 1997

COMMISSION

LAND CORNER RECORDATION CERTIFICATE Filing Requirement of Act 74, Mich. P.A. 1970

Register's Office
Gogebic County

For corners in

Gogebic

(County)

Located In:

Corner Code #

1. Public Land Survey

T 50N R 45W

C-12

T R

T R

T R

T R

2. Property Controlling
in Section

S T

T R

S T

T R

3. Miscellaneous
Property in Sec.

S T

T R

Received for record the
16th day of AUGUST
A. D. 1996 at 2:30 o'clock
P. M., and recorded in
Liber 6 of CORNERS

Page 43

Richard D. Brown
Register of Deeds

Register of Deeds Stamp & File Number

4. Lot No. , Recorded Plat

5. Private Claims

1/4 cor. comm. to sec's. 31 & 32

I, John P. GOSS, in a field survey on Aug. 29, 1996 do hereby state that under requirements of P.A. 74, Michigan P.A. of 1970, the corner points mentioned in lines 1 and 2 above were in conformance with regulations and rules therefore as required in the current manual of survey instructions of the United States Department of the Interior, Bureau of Land Management or by a decree of a Court of Law and/or that the corner points mentioned in lines 3, 4 and 5 above were in conformance with the rules of the Michigan Board of Land Surveyors or by a Decree of a Court of Law; established, re-established, monumented, recovered, found as expressed below:

NOTE: Not more than 2 corners, all in the same town and range, may be recorded on this certificate.

	A	B	C	D	E	F	G	H	I	J	K	L	M
1													
2	6		5		4		3		2		1		
3													
4	7		8		9		10		11		12		
5													
6	18		17		16		15		14		13		
7													
8	19		20		21		22		23		24		
9													
10	30		29		28		27		26		25		
11													
12	31		32		33		34		35		36		
13													

A. Description of original monument and accessories and/or subsequent restoration:

Original corner established by Austin Burt on July 26, 1848. Set Hemlock post.
Original bearing trees: Lynn 20" S 73° E 24 links
Sugar 12" N 88° W 28 links

Keith Sackett, R.L.S. of D.N.R. restored the corner by possible original bearing tree: Sugar 12"- N 88° W- 28 links. He set a 1" iron pipe with 4" aluminum cap stamped to noted corner location. He recorded corner in Liber 2 on page 116 of Land Corners for Gogebic County, with the following bearing trees: 7" Hemlock- S 20° E- 13.4', 1/4 S, NBT; 32" Sugar- N 15° E- 10.3', 1/4 S, NBT; 28" Sugar- N 88° W- 17.6', 1/4 S, NBT. K. Sackett restored the corner on July 29, 1980.

B. Description of corner evidence found and/or method applied in restoring or reestablishing corner:

Found the 1" iron pipe with 4" aluminum cap stamped to noted corner location and it checked with Sackett witnesses on his certification. I updated the corner accessories as noted below to state and county specification.


Act 74 research on file.

PEAR GROUP ATTORNEY
Richard P. Brown 9/12/96
COUNTY

C. Description of monument for corner and accessories established to perpetuate locating the position of the corner:

From the 1" iron pipe with 4" aluminum cap stamped to note corner location. I established the following existing and new bearing trees and reference objects.

9" Hemlock	S 20° E	13.73'	1/4 S, NBT
34" Sugar	N 15° E	11.24'	1/4 S, NBT
30" Sugar	N 88° W	19.14'	1/4 S, NBT
22" Hemlock	S 54° W	41.70'	
6' Rail & sign	Due N.	1.50'	

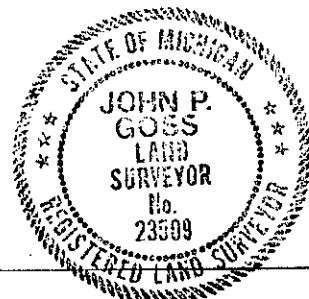

Signed by John P. Goss

Date Aug 29, 1996

Surveyor's Michigan License No. 23509

Fed. No. X-5