
LAND CORNER RECORDATION CERTIFICATE Filing Requirement of Act 74, Mich. P.A. 1970 as Amended


For corners in

Houghton	Located In:	Corner Code #	8
(County)	- 4		
1. Public Land Survey	T R R T R		ži-
2. Property Controlling in Section	S 27 T 52N R 35W S 27 T 52N R 35W S T R	3 10	
3. Miscellaneous Property in Sec.	S T R R	<u> </u>	Register of Deeds Sta
4. Lot No. , Re 5. Private Claims	ecorded Plat		A B C D E F

mp & File Number

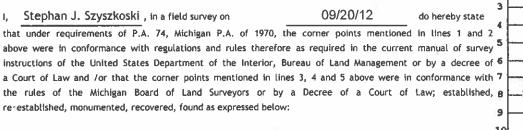

NOTE: Not more than 2 corners, all in the same town and range, may be recorded on this certificate.

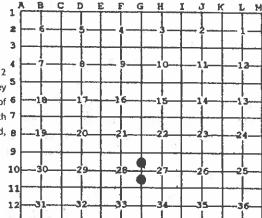

A. Description of original monument and accessories and/or subsequent restoration:

(3-Sec. 27) North 1/16 corner between Sections 27 and 28. Not previously monumented.

(10-Sec. 27) South 1/16 corner between Sections 27 and 28. Not previously monumented.

B. Description of corner evidence found and/or method applied in restoring or reestablishing corner:

(3-Sec. 27) Established the position for the corner midway and on the Section line between Quarter corner 1321.22' south and Section corner 1321.22' north.

(10-Sec. 27) Established the position for the corner midway and on the Section line between Quarter corner 1332.63' north and Section corner 1332.63' south.

C. Description of monument for corner and accessories established to perpetuate locating the position of the corner:

(3) Set 1"IDx32" I.pipe with 4" alum. MDNR cap. Set measuring nail with MDNR tag in the side of: 5" Sugar N14W 29.1' mrkd "1/16S BT" 12" Sugar N73E 18.9' do 7" Sugar S10E 14.55' do 5" Sugar S84W 6.25' do Set Sq'd Cedar post adjacent. E=7867209.233 N=234034.784

(10) Set 1"IDx32" I.pipe with 4" alum. MDNR cap. Set measuring nail with MDNR tag in the side of: 6" Sugar N29E 2.55' mrkd "1/16S BT" 5" dbl. Y.Birch N75E 14.0' do 7" dbl. Sugar S08W 35.3' 7" Sugar N85W 34.95' C/L of E-W 2-track is 13.5' south. Set cedar post adjacent. E=7867170, 086 N-233226.914

Bearings are magnetic. Coordinates are MCS83 in meters.

Date 02/27/2013

FORM APPROVED BY MICHIGAN STATE BOARD

Surveyor's Michigan License No.

33986

For the Michigan Department of Natural Resources, Forest Resources Division

rised Jan., 1983 Revised Oct., 1995

SZYSZKOSKI

LAND

RVEYOR