

LAND CORNER RECORDATION CERTIFICATE  
Filing Requirement of Act 74, Mich. P.A. 1970

SURVEY A  
RECONVENE

For corners in

HOUGHTON  
(County)

Located In:

Corner Code #

DEC 14 1998

SECTION

1. Public Land Survey T 53W R 33W  
T 53W R 33W  
T R  
T R  
2. Property Controlling S T R  
in Section S T R  
3. Miscellaneous S T R  
Property in Section S T R

K-5  
MEANDER-12

Seg-1

ROBERT F. MIKESCH 11/16/98  
HOUGHTON COUNTY, REGISTER 14:46  
LC 3/ 547 PAU Fee: 9.00  
Page 1 of 1

4. Lot No. , Recorded Plat  
5. Private Claims

I, R. W. CRAMPTON, in a field survey on OCTOBER 22, 19 98,  
do hereby certify that under requirements of P.A. 74, Michigan P.A. of 1970, the corner points mentioned  
in lines 1 and 2 above were in conformance with regulations and rules therefore as required in the current  
manual of survey instructions of the United States Department of the Interior, Bureau of Land  
Management or by a decree of a Court of Law and/or that the corner points mentioned in lines 3, 4 and  
5 above were in conformance with the rules of the Michigan Board of Professional Surveyors or by a  
Decree of a Court of Law; established, re-established, monumented, re-monumented, recovered, found  
as expressed below:

NOTE: Not more than 4 corners, all in the same town and range, may be recorded  
on this certificate.

A. Description of original monument and accessories and/or subsequent restoration:

K-5, SET POST SECTIONS 11, 12, 13 & 14, Y. BIRCH 15 S51W 20, MAPLE 12 N64E 23.

MEANDER-12, SET MEANDER POST IN MARSH 2494.14' NORTH OF SOUTHWEST CORNER OF SECTION 12.

B. Description of corner evidence found and/or method applied in restoring or reestablishing corner:


K-5, FOUND 5/8" CAPPED ROD IN 4" SQUARE MONUMENT, FROM SURVEY BY EWART MULLER DATED  
JULY 1980, AND SURVEY U.P. ENGINEERS & ARCHITECTS, INC. DATED 10/26/95.

MEANDER-12, FOUND 1/2" IRON ROD IN 4" ROUND MONUMENT (BROKEN), FROM SURVEY BY EWART  
MULLER DATED JULY 1980.

C. Description of monument for corner and accessories established to perpetuate locating the position of the corner:

K-5 LEFT MONUMENT IN PLACE AND SET 1 1/4" IRON PIPE WITH 2 1/4" BRASS CAP NEXT TO MONUMENT,  
FOUND BRASS TAGS (U.P. ENG. #18983) NAILED TO: 13" W. BIRCH TREE S45°W 392.82', 8" W. BIRCH  
TREE S24°W 335.63', 7" R. MAPLE TREE S12°E 340.80', 36" W. PINE TREE N45°E 352.92'.

MEANDER-12 REPLACED MONUMENT WITH 1 1/4" IRON PIPE WITH 2 1/4" BRASS CAP, WITNESSED WITH  
SURVEY TAG NAILED TO: 12" ASPEN TREE S34°W 337.60', TRIPLE 12" SPRUCE TREE S48°E  
120.41', N68°W 69.07' TO 12" CORP. OF ENG. MONUMENT #131, N42°W 125.21' TO  
5/8" IRON ROD WITH PLASTIC CAP.

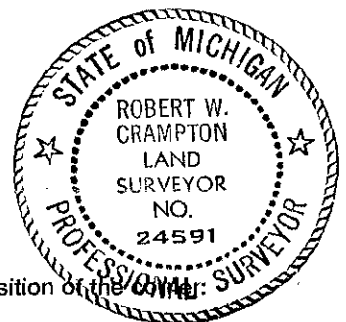

Signed by

Robert W. Crampton

Date

Nov 4, 1998

Surveyor's Michigan License No.

24591